


Storm Water Asbuilt Sheet Index
SW Catchment 19r

Compiled on 2021-06-15 from as-buils of various dates. For up to date as-buils please visit http://geo.rdc.govt.nz/images/plotfiles/3waters_mobile_asbuils/




U16-1000/43.03

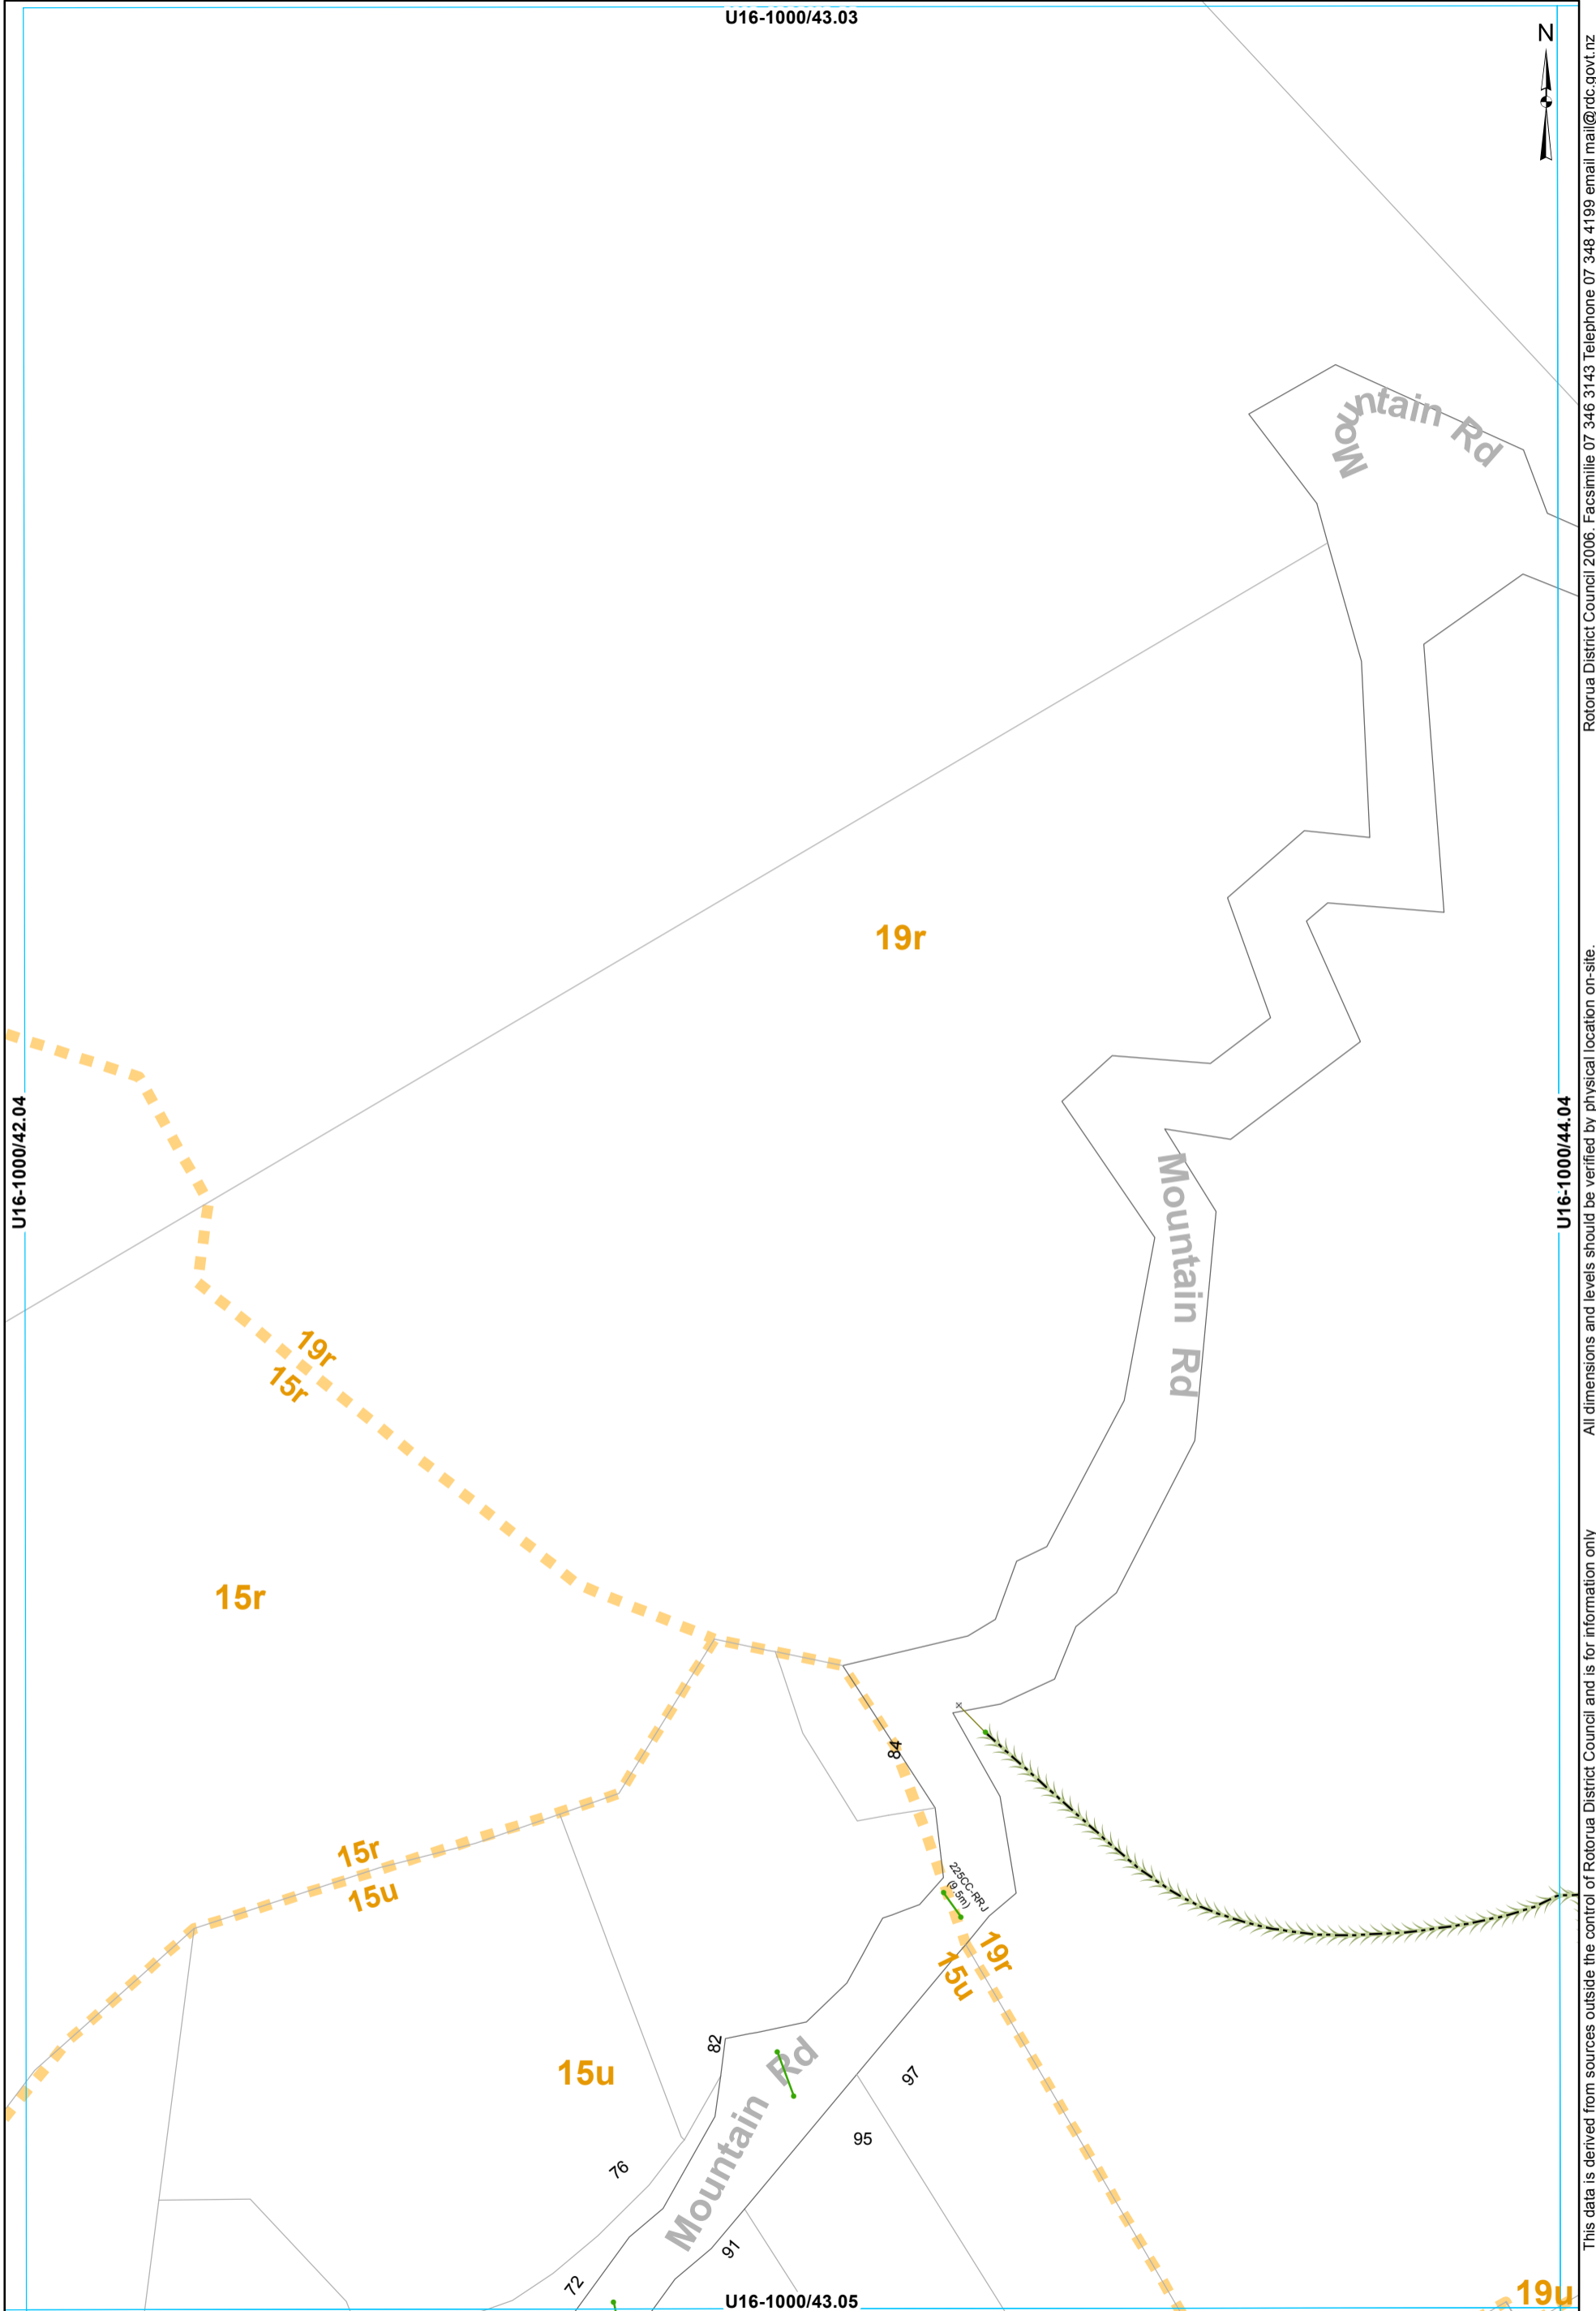

- × SWInlet
- Node
- Overland Flow
- Culvert
- SWLead
- Catchment Boundary

STORMWATER SERVICES
1:2000 @ A3 - (U16-1000/43.04)

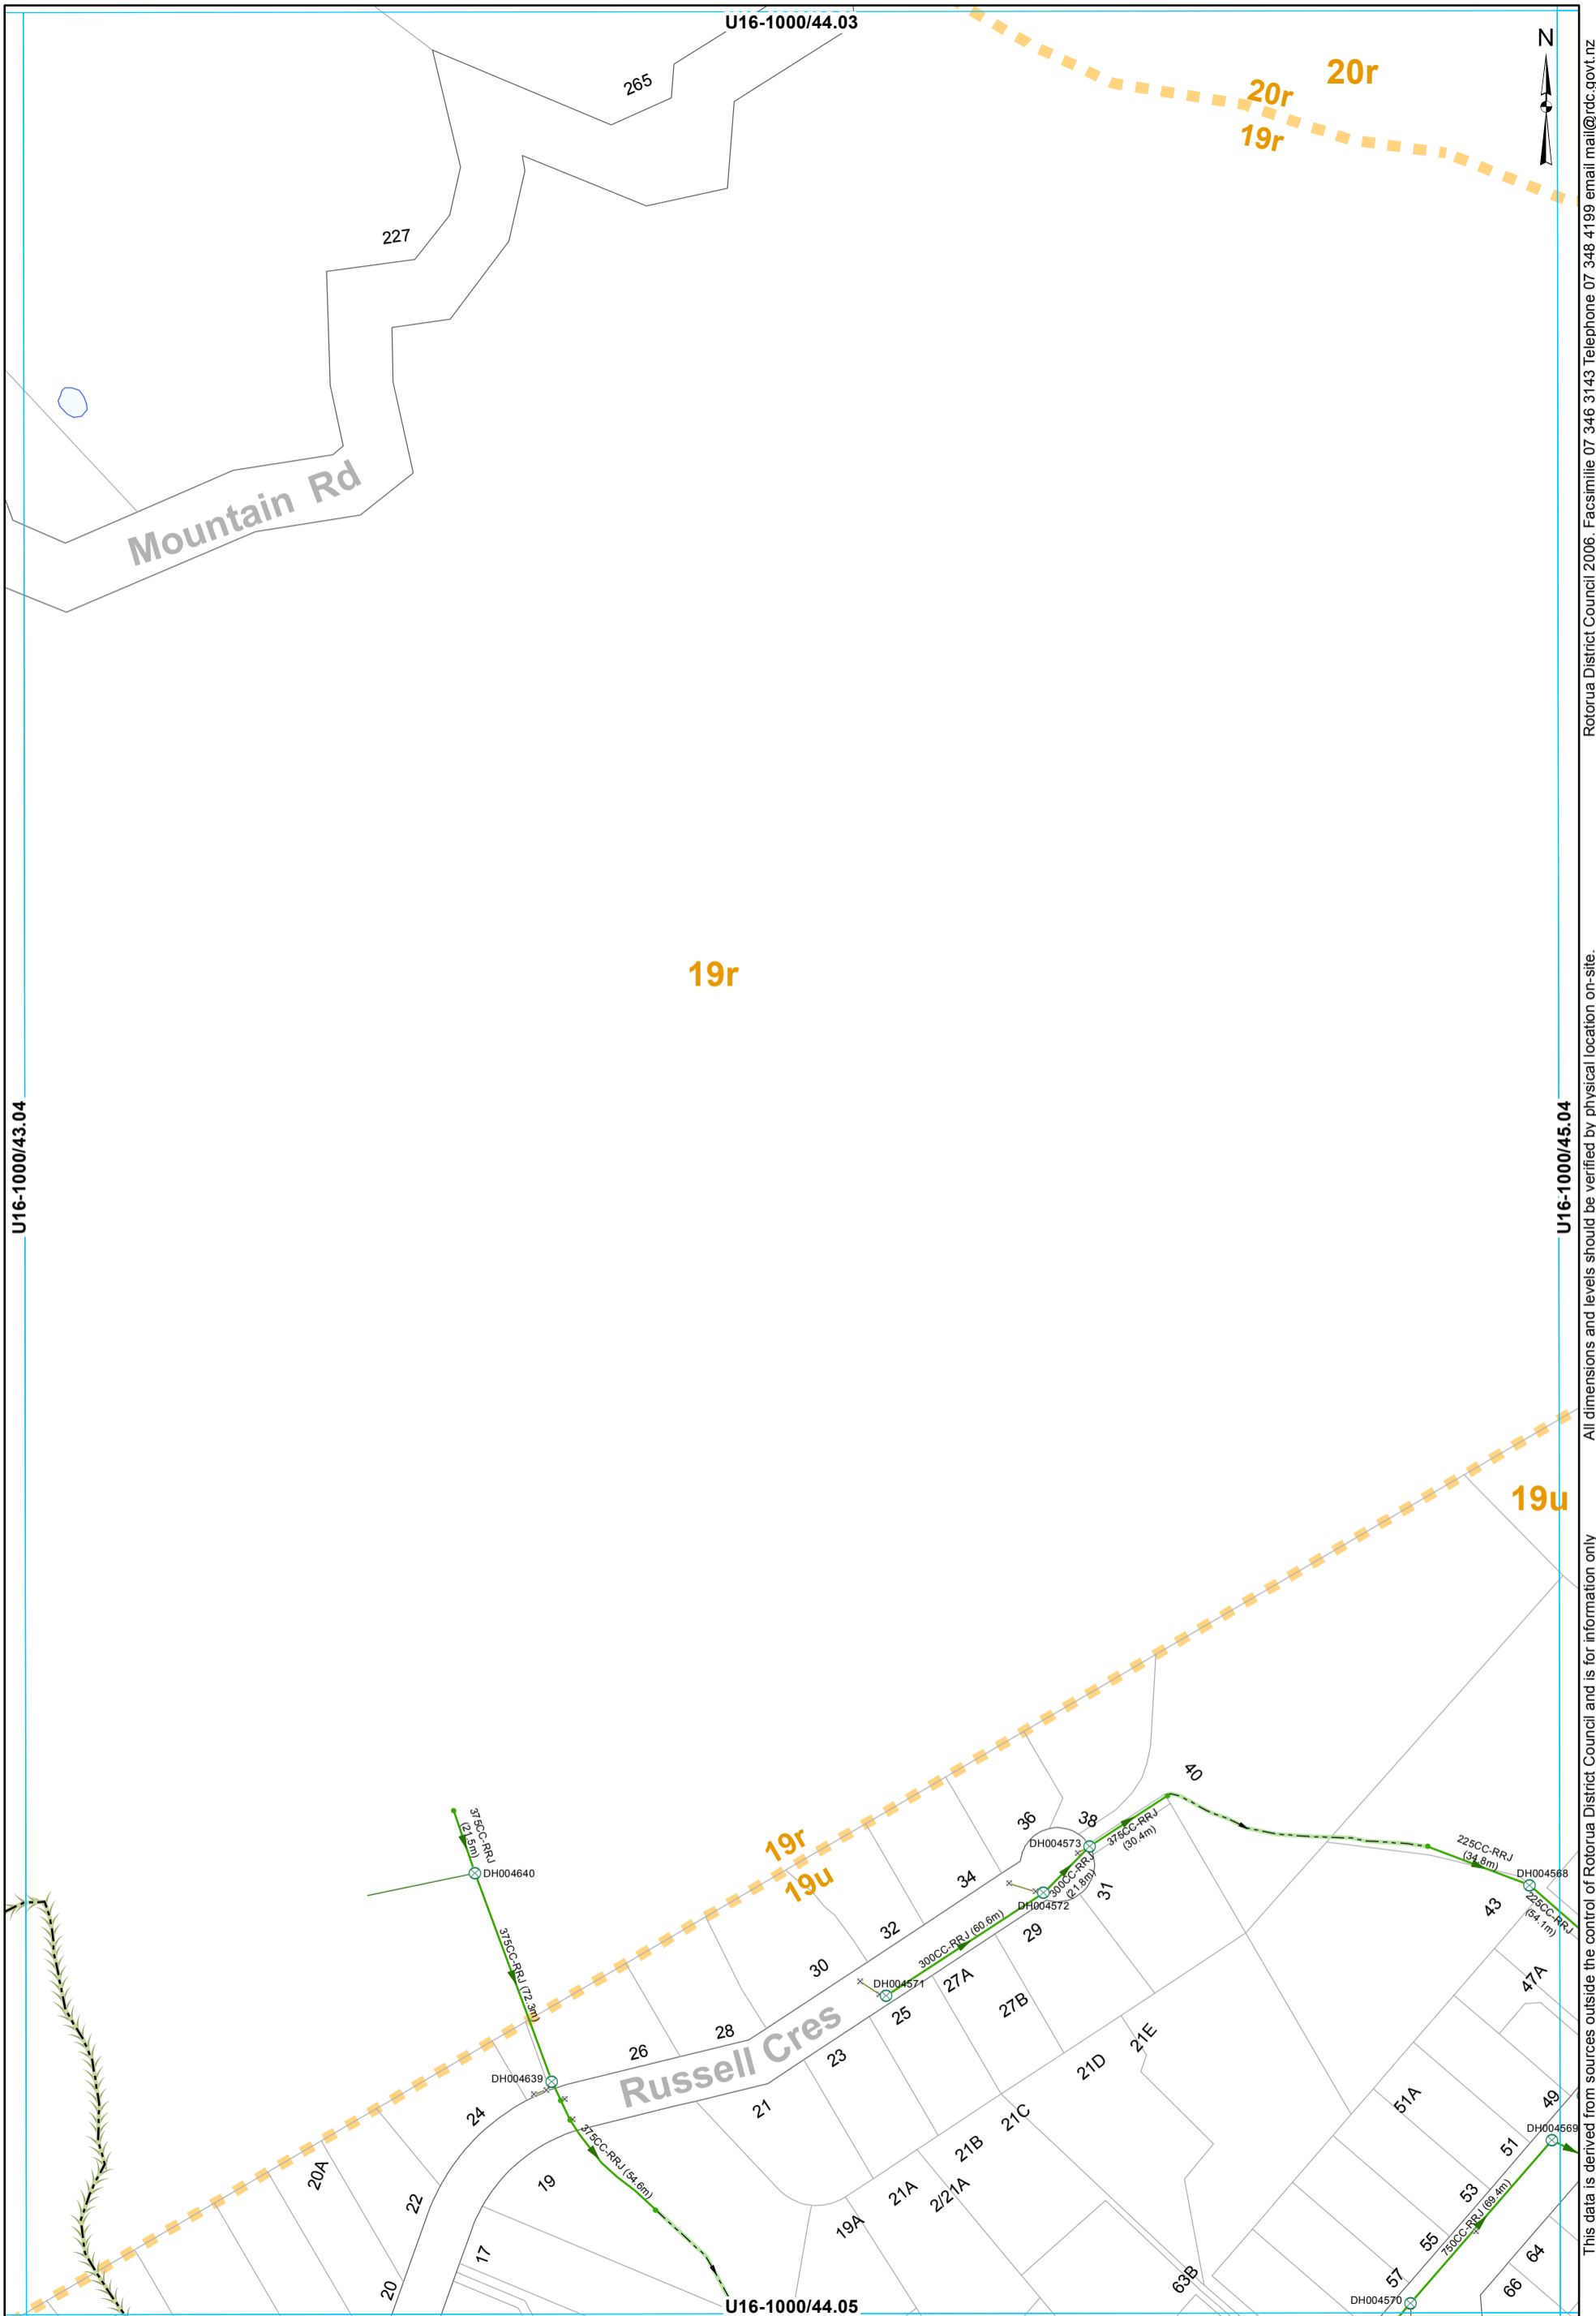

- o SWManhole
- x SWInlet
- Node
- Open Drain
- Overland Flow
- Gravity Main
- SWServiceline
- SWLead
- Catchment Boundary


STORMWATER SERVICES
1:2000 @ A3 - (U16-1000/44.04)

U16-1000/43.04

U16-1000/45.04

This data is derived from sources outside the control of Rotorua District Council and is for information only. All dimensions and levels should be verified by physical location on-site.

Rotorua District Council 2006. Facsimile 07 346 3143 Telephone 07 348 4199 email mail@rdc.govt.nz

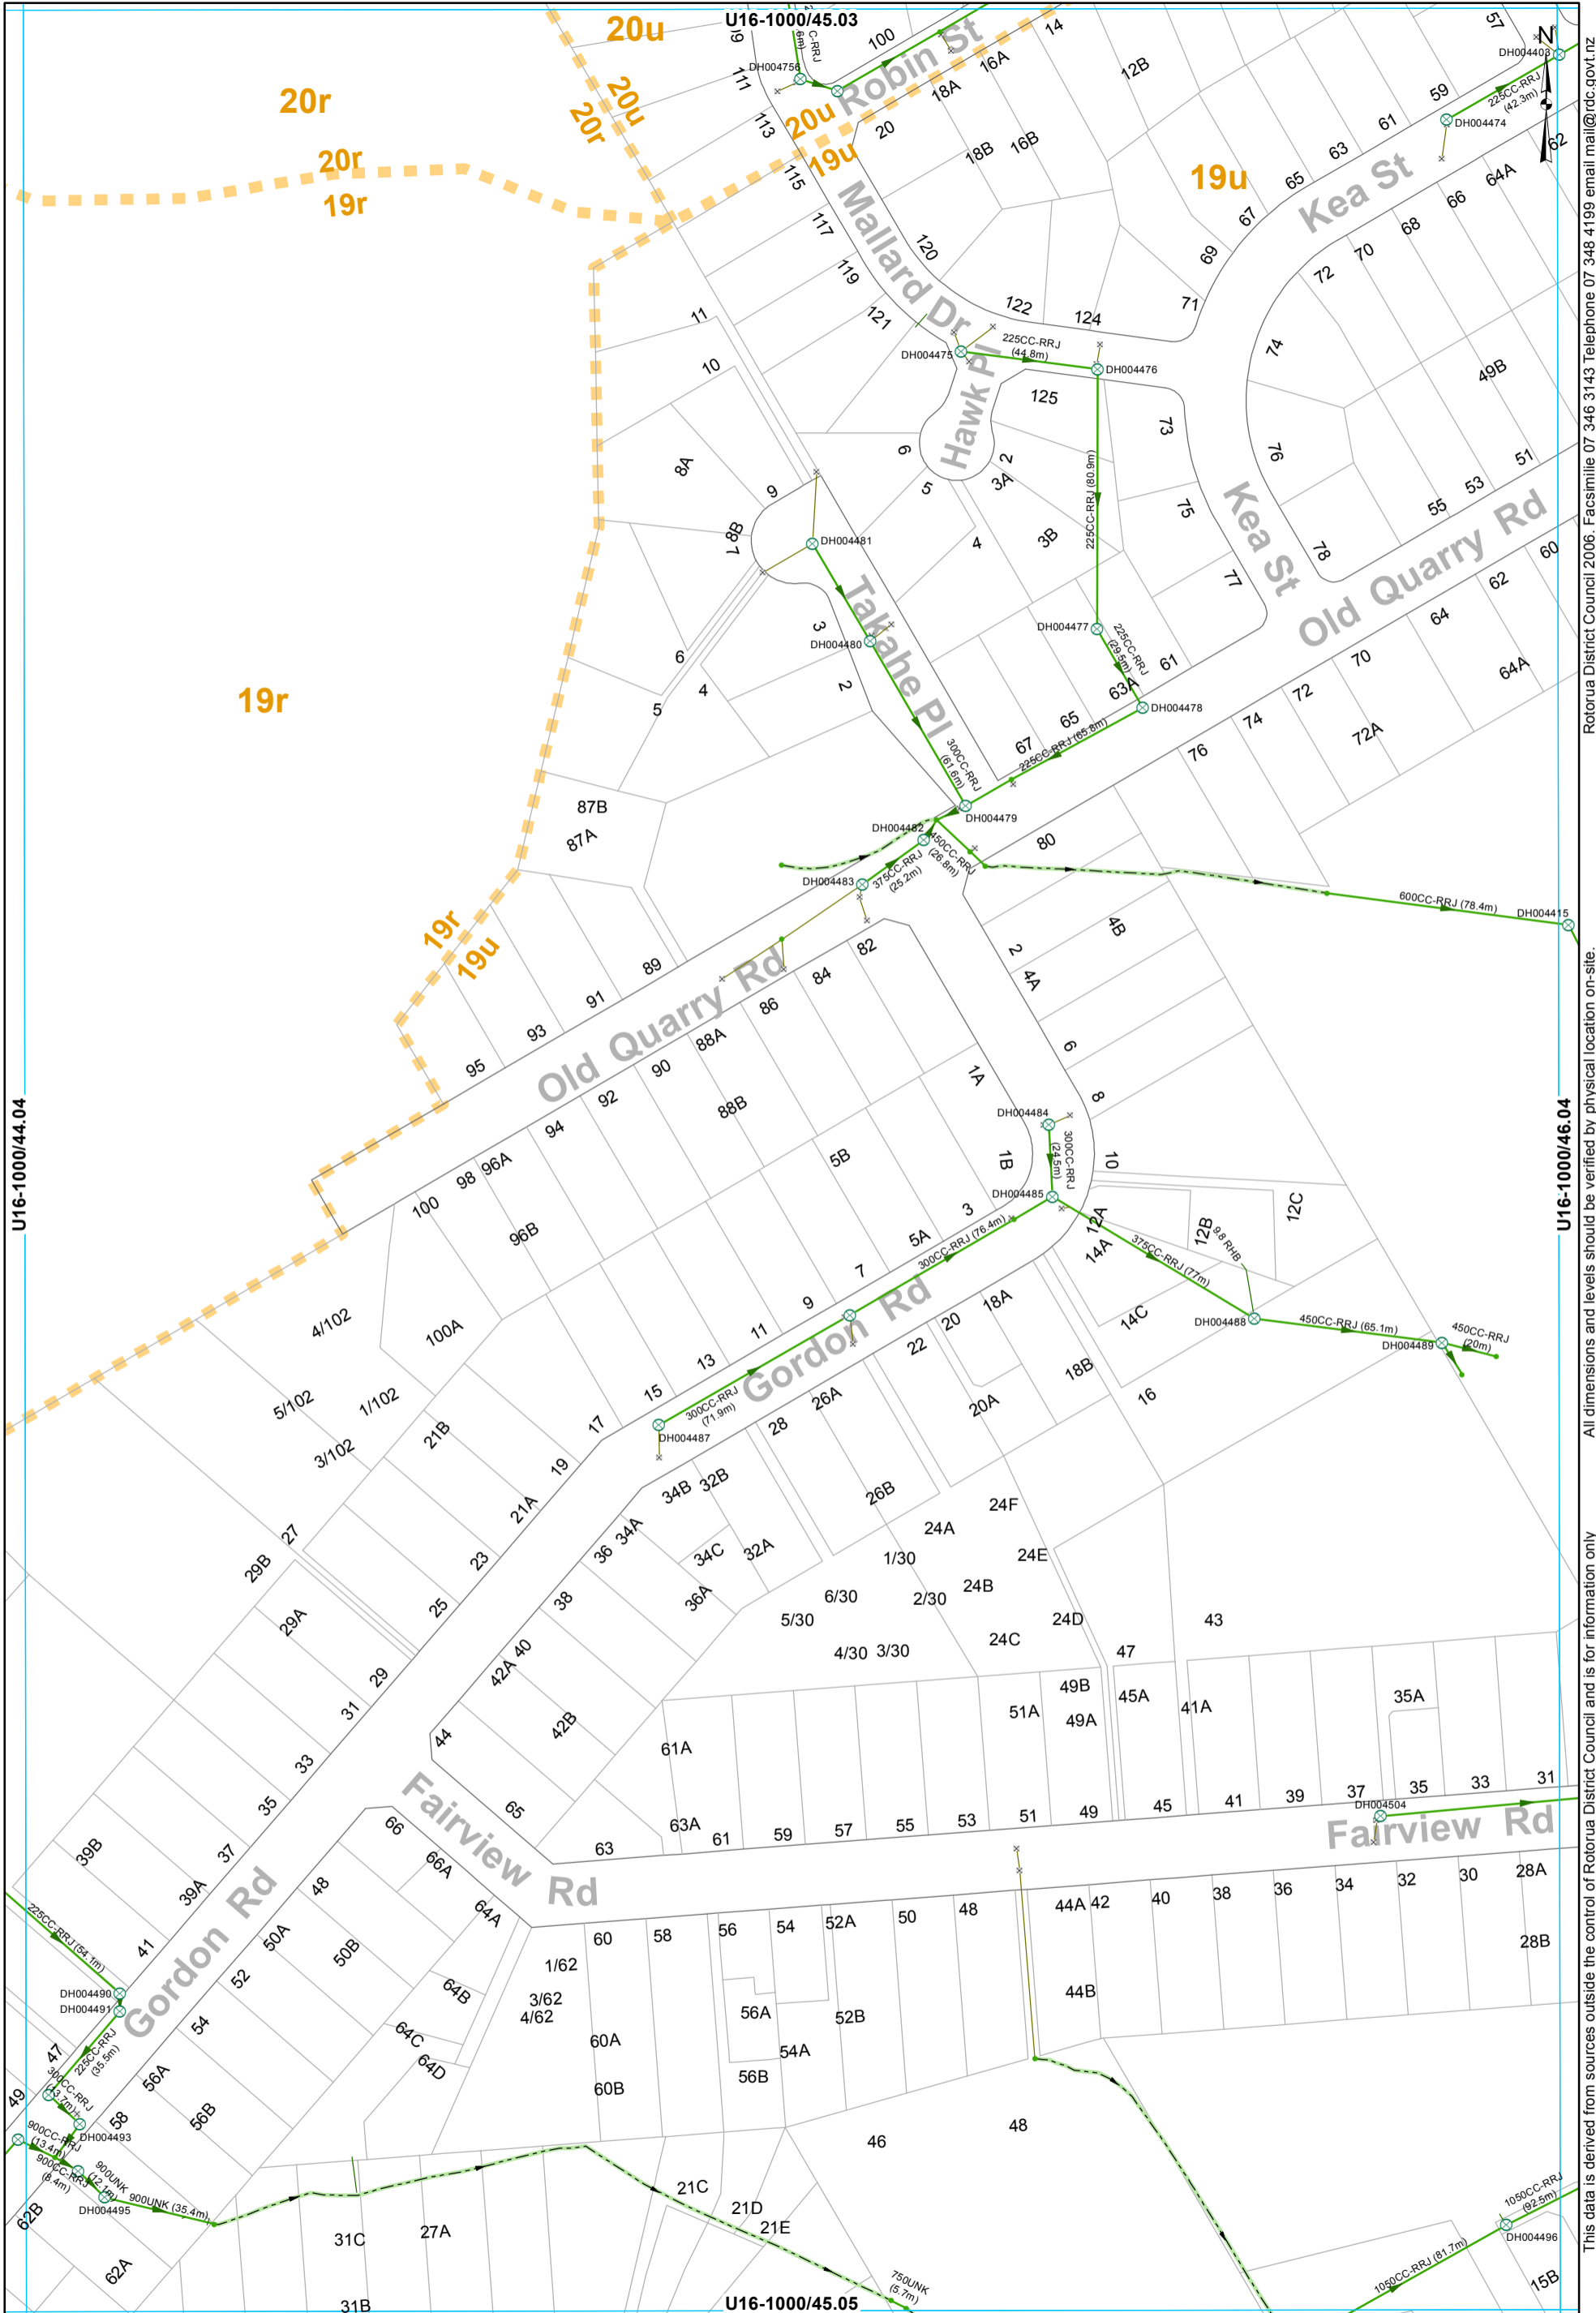

- ⊗ SWManhole
- × SWInlet
- Node
- Open Drain
- Culvert
- Gravity Main
- SWServiceline
- SWServiceline
- SWLead
- Catchment Boundary

STORMWATER SERVICES
1:2000 @ A3 - (U16-1000/45.04)

This data is derived from sources outside the control of Rotorua District Council and is for information only

All dimensions and levels should be verified by physical location on-site.

Rotorua District Council 2006. Facsimile 07 346 3143 Telephone 07 348 4199 email mail@rdc.govt.nz



- ⊗ SWManhole
- ⊗ SWInlet
- Node
- Open Drain
- Culvert
- Gravity Main
- SWServiceline
- SWServiceline
- SWLead
- Catchment Boundary

STORMWATER SERVICES
1:2000 @ A3 - (U16-1000/43.05)

This data is derived from sources outside the control of Rotorua District Council and is for information only

All dimensions and levels should be verified by physical location on-site.

Rotorua District Council 2006. Facsimile 07 346 3143 Telephone 07 348 4199 email mail@rdc.govt.nz