


Storm Water Asbuilt Sheet Index
SWCatchment 21u



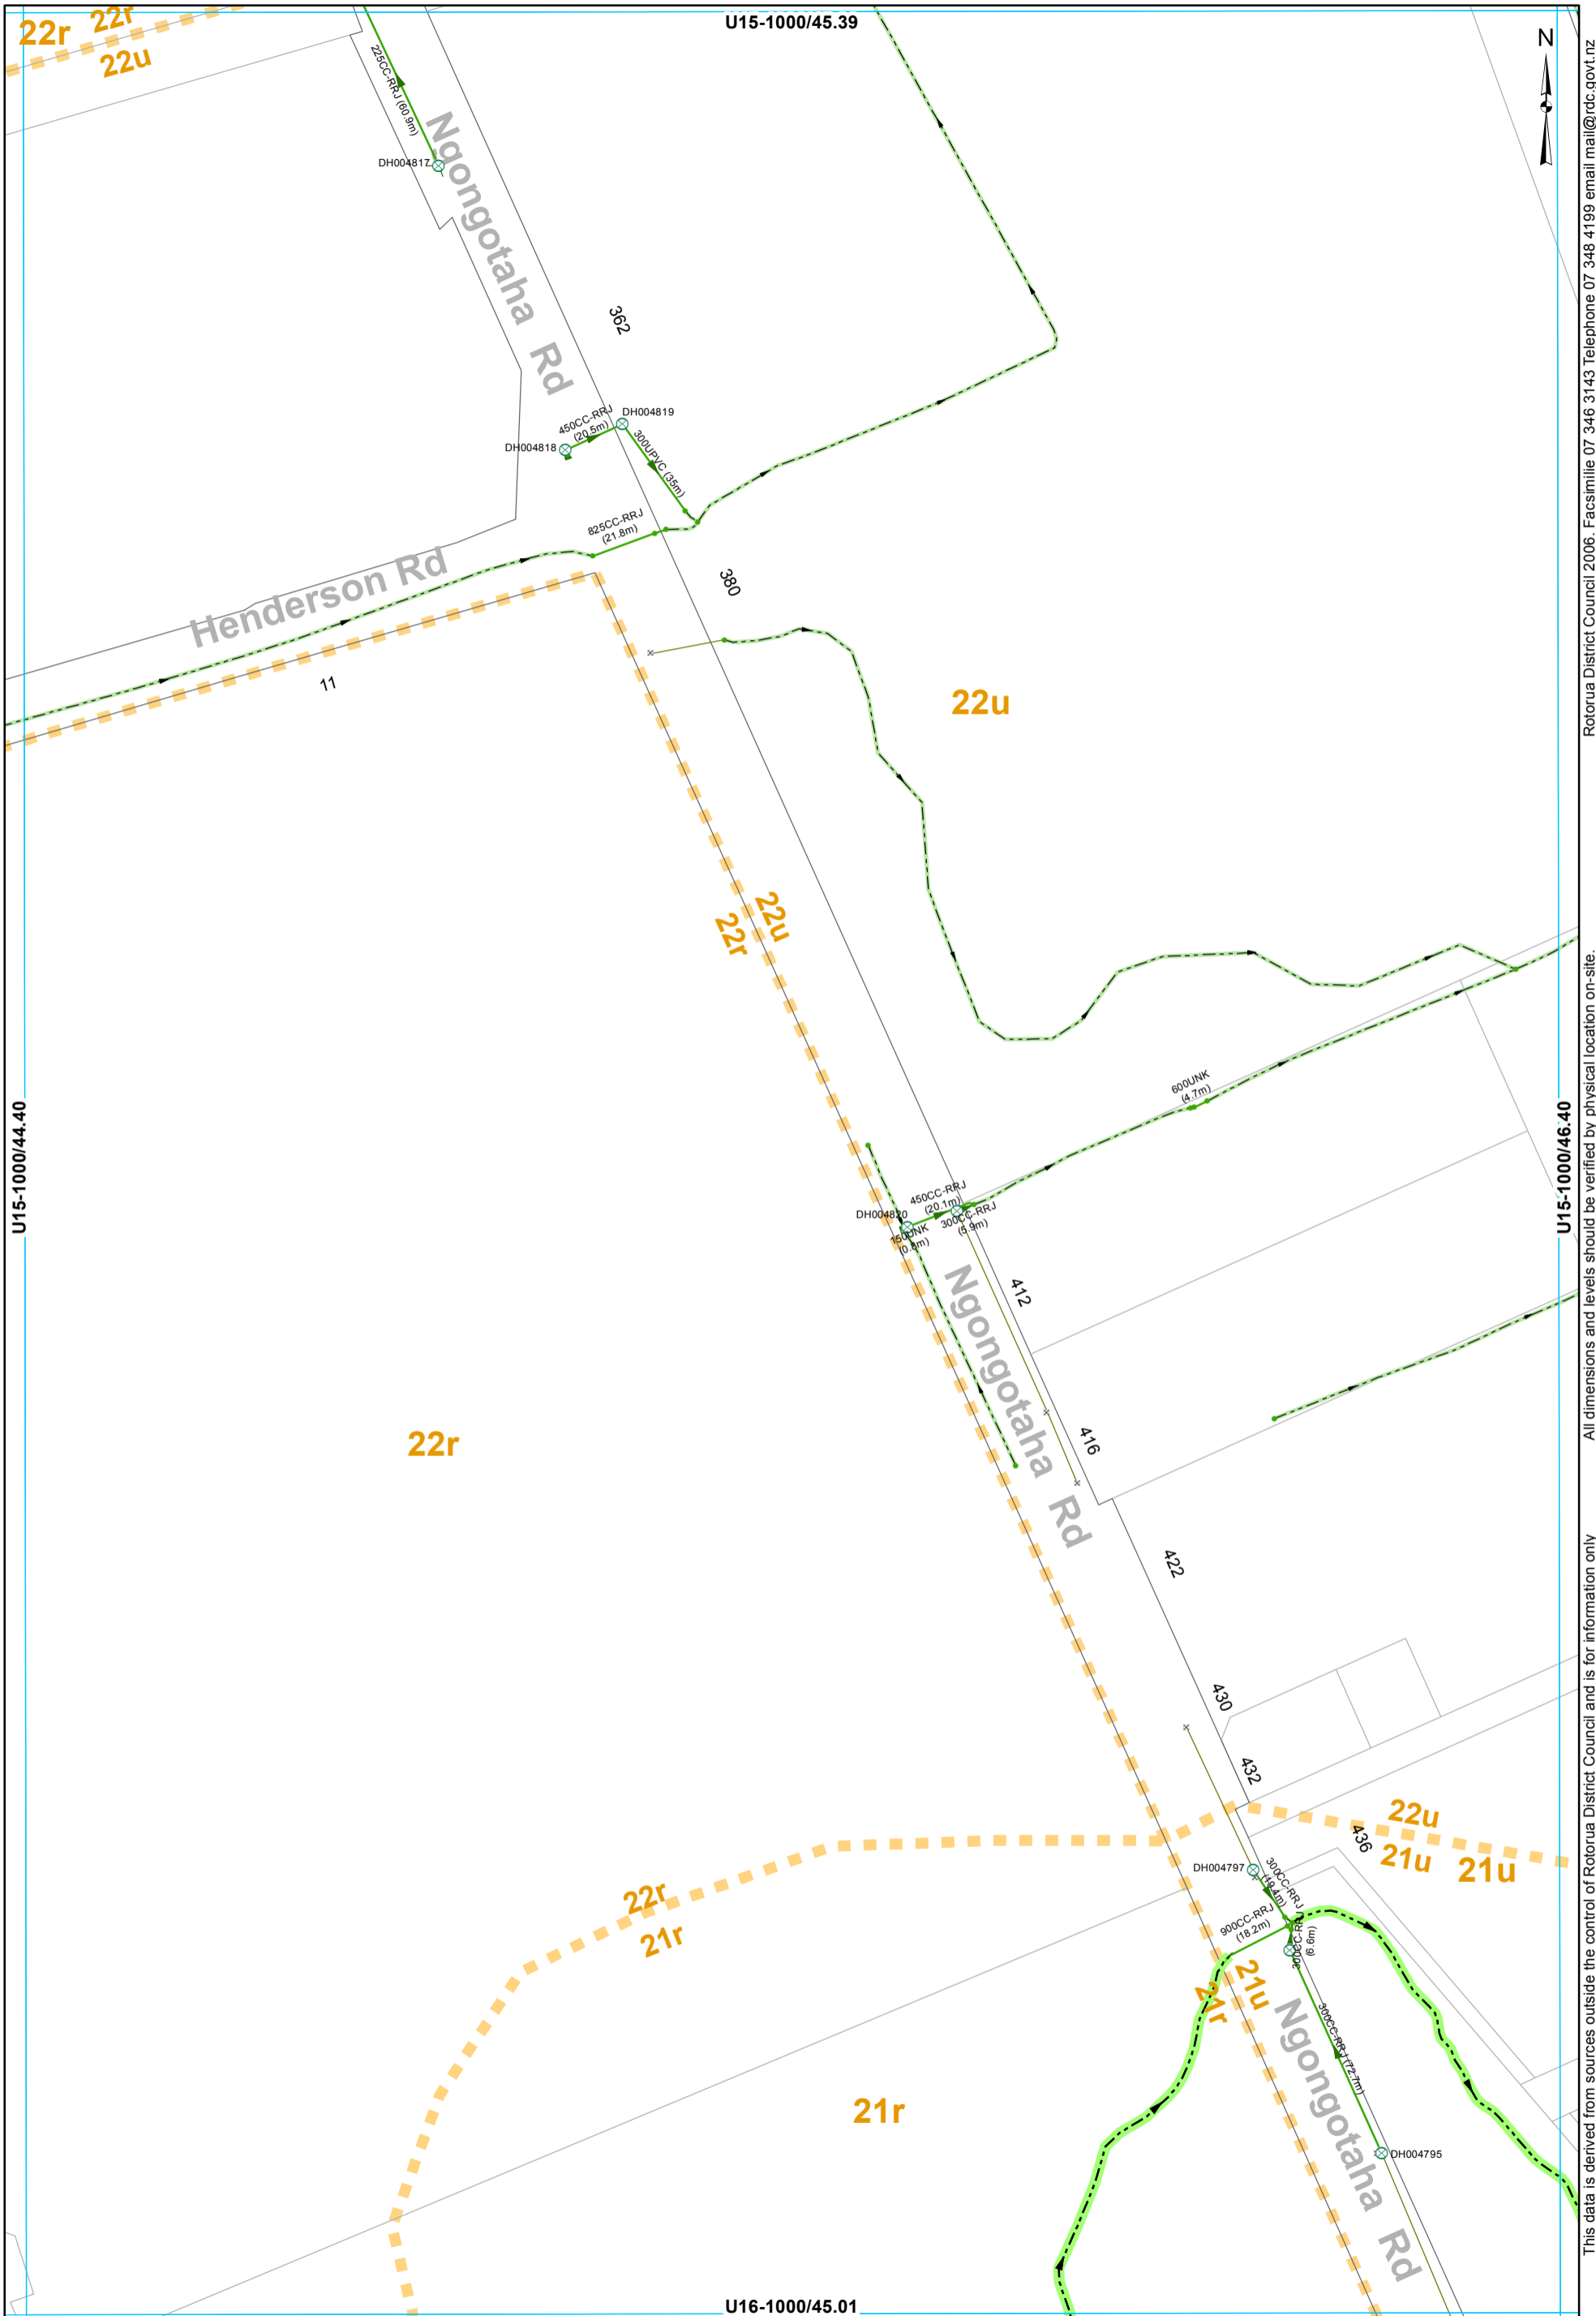


- ⊗ SWManhole
- × SWInlet
- Node
- Headwall Structure
- Open Drain
- Stream
- Culvert
- Gravity Main
- SWServiceline
- SWServiceline
- SWLead
- Catchment Boundary

STORMWATER SERVICES
1:2000 @ A3 - (U15-1000/45.40)

This data is derived from sources outside the control of Rotorua District Council and is for information only

All dimensions and levels should be verified by physical location on-site.

Rotorua District Council 2006. Facsimile 07 346 3143 Telephone 07 348 4199 email mail@rdc.govt.nz

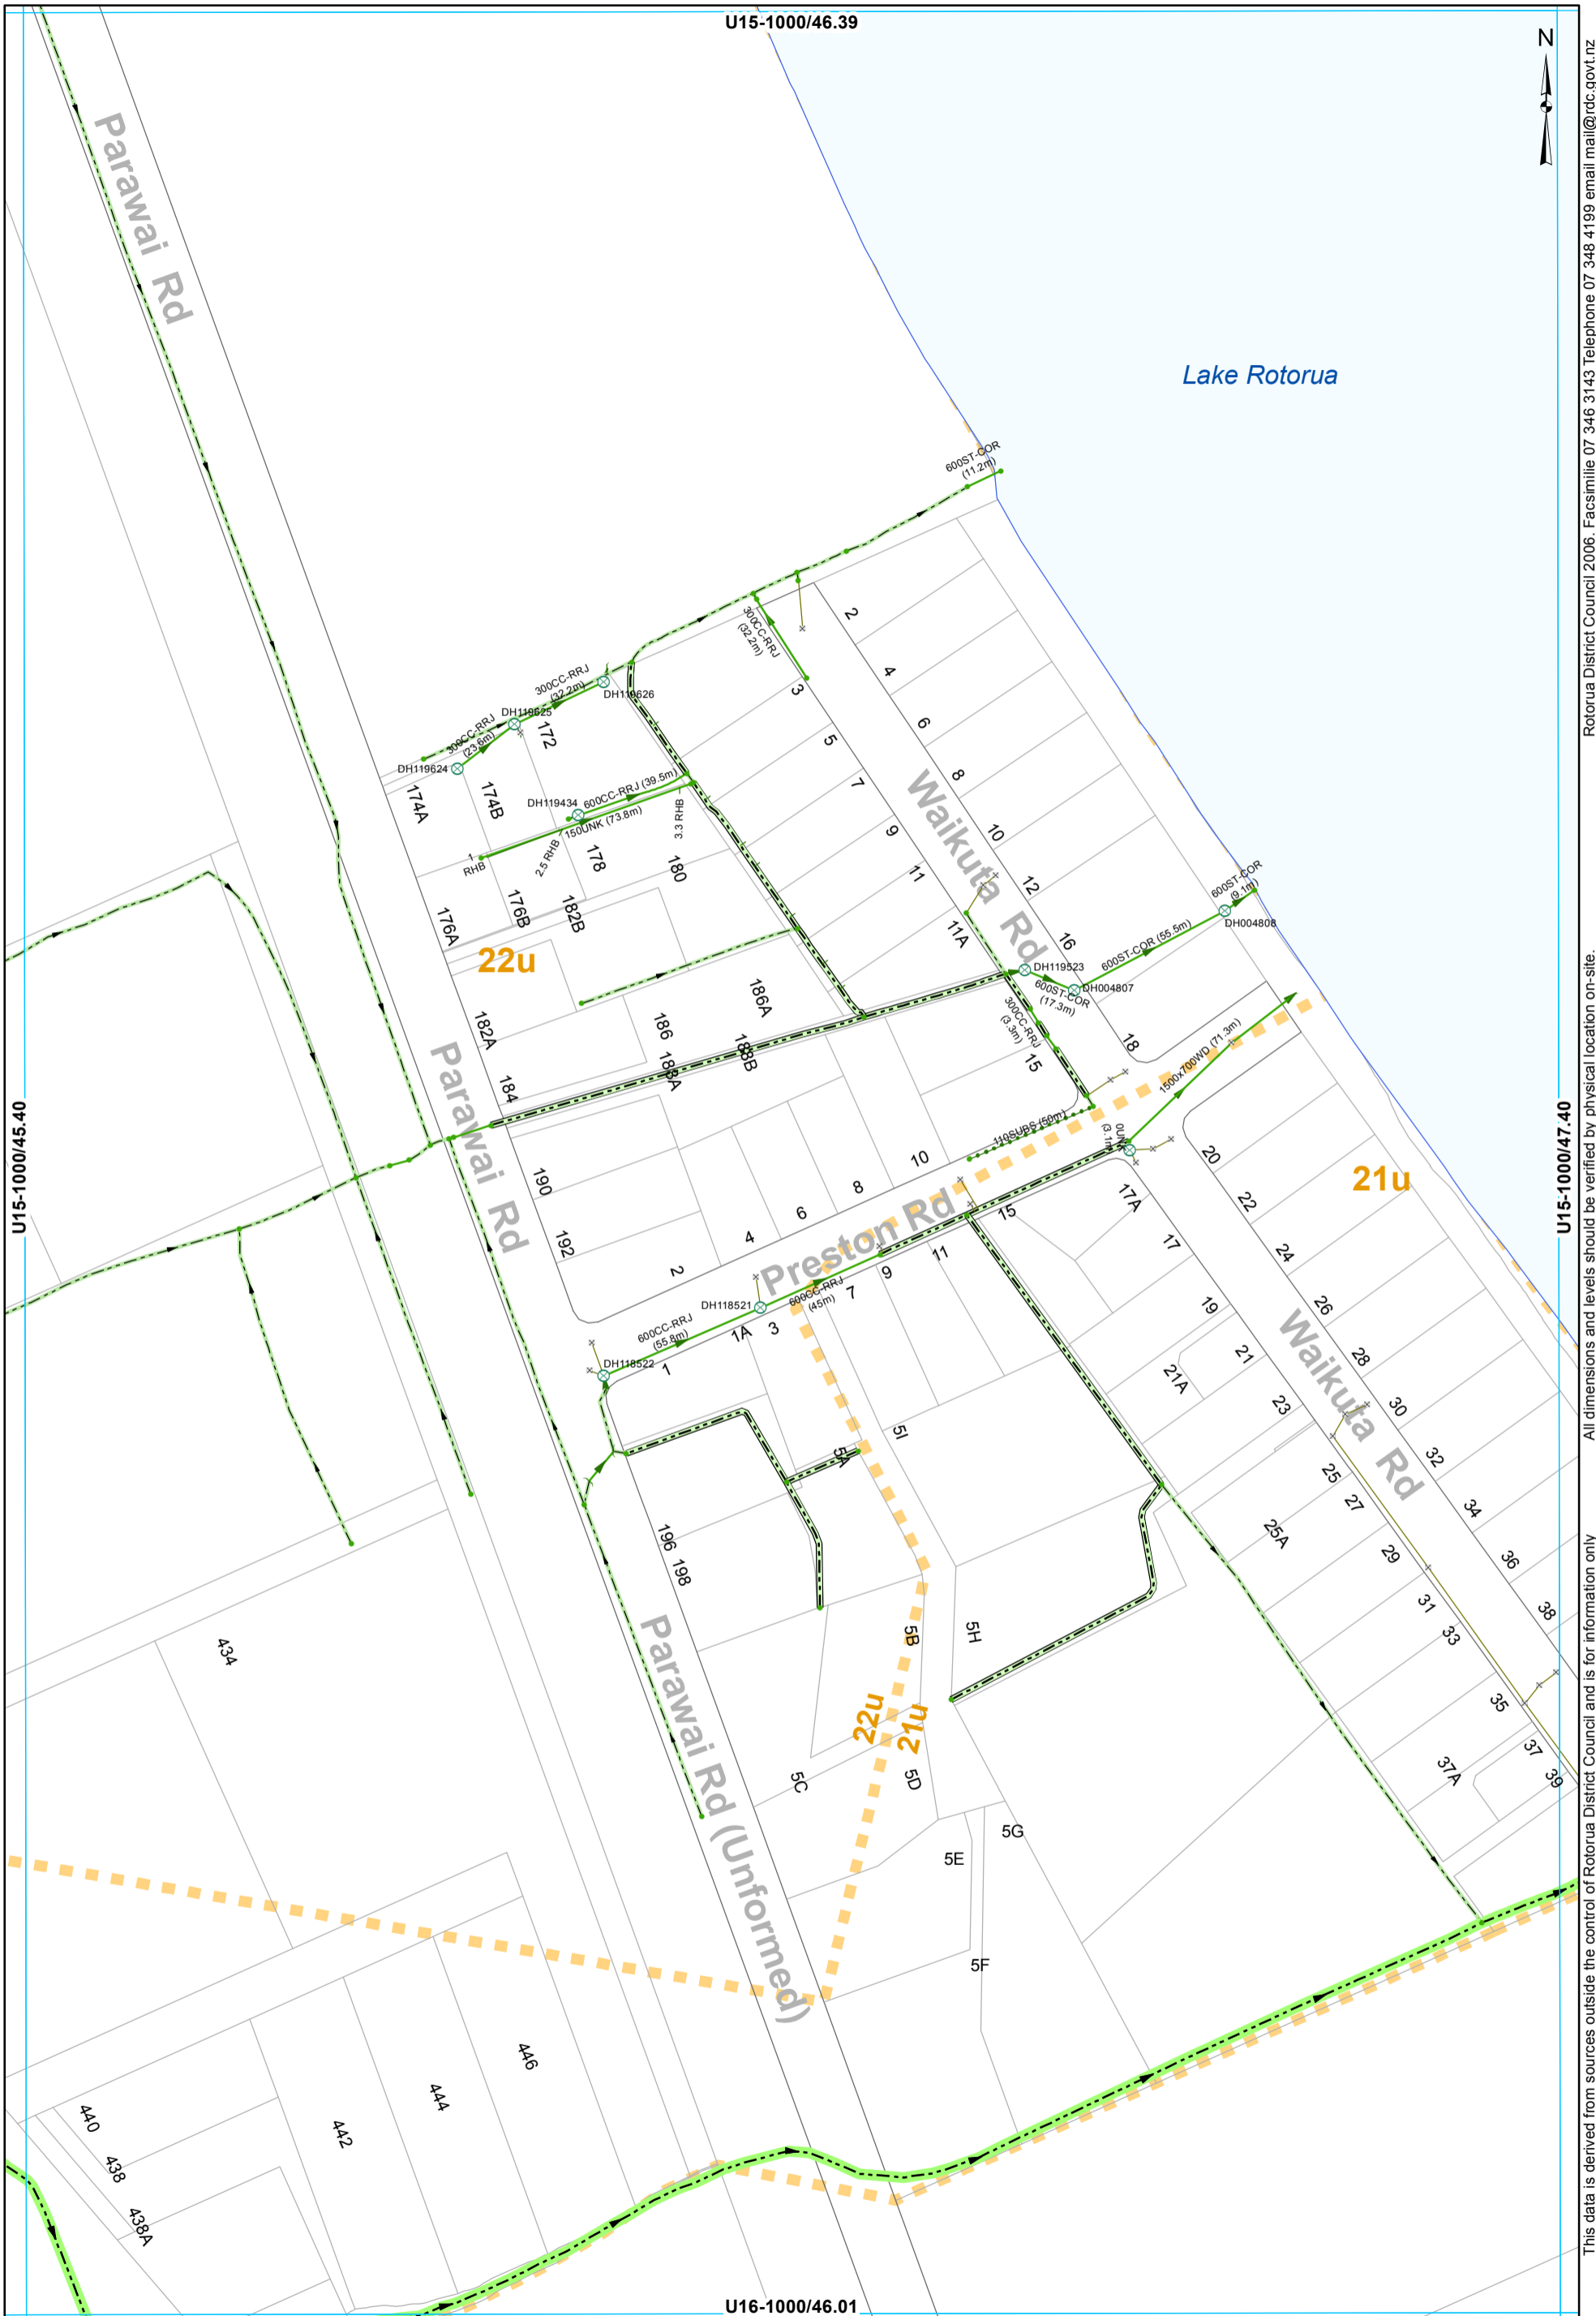

Rotorua District Council 2006. Facsimile 07 346 3143 Telephone 07 348 4199 email mail@rdc.govt.nz
 All dimensions and levels should be verified by physical location on-site.
 This data is derived from sources outside the control of Rotorua District Council and is for information only

- | | | | |
|----------------------|-----------------|----------------------|----------------------|
| ⊗ SWManhole | ▬ Lined Channel | — Culvert | SWServiceline |
| × SWInlet | ▬ Open Drain | — Gravity Main | — SWServiceline |
| ● Node | ▬ Stream | — Subsoil Drain | — SWLead |
| — Headwall Structure | | ▬ Catchment Boundary | |

STORMWATER SERVICES
1:2000 @ A3 - (U15-1000/46.40)

U15-1000/47.39



Lake Rotorua

U15-1000/46.40

U15-1000/48.40



21u


- × SWInlet
- Node
- Open Drain
- Stream
- SWLead
- Catchment Boundary

U16-1000/47.01

STORMWATER SERVICES
1:2000 @ A3 - (U15-1000/47.40)

This data is derived from sources outside the control of Rotorua District Council and is for information only

Rotorua District Council 2006. Facsimile 07 346 3143 Telephone 07 348 4199 email mail@rdc.govt.nz

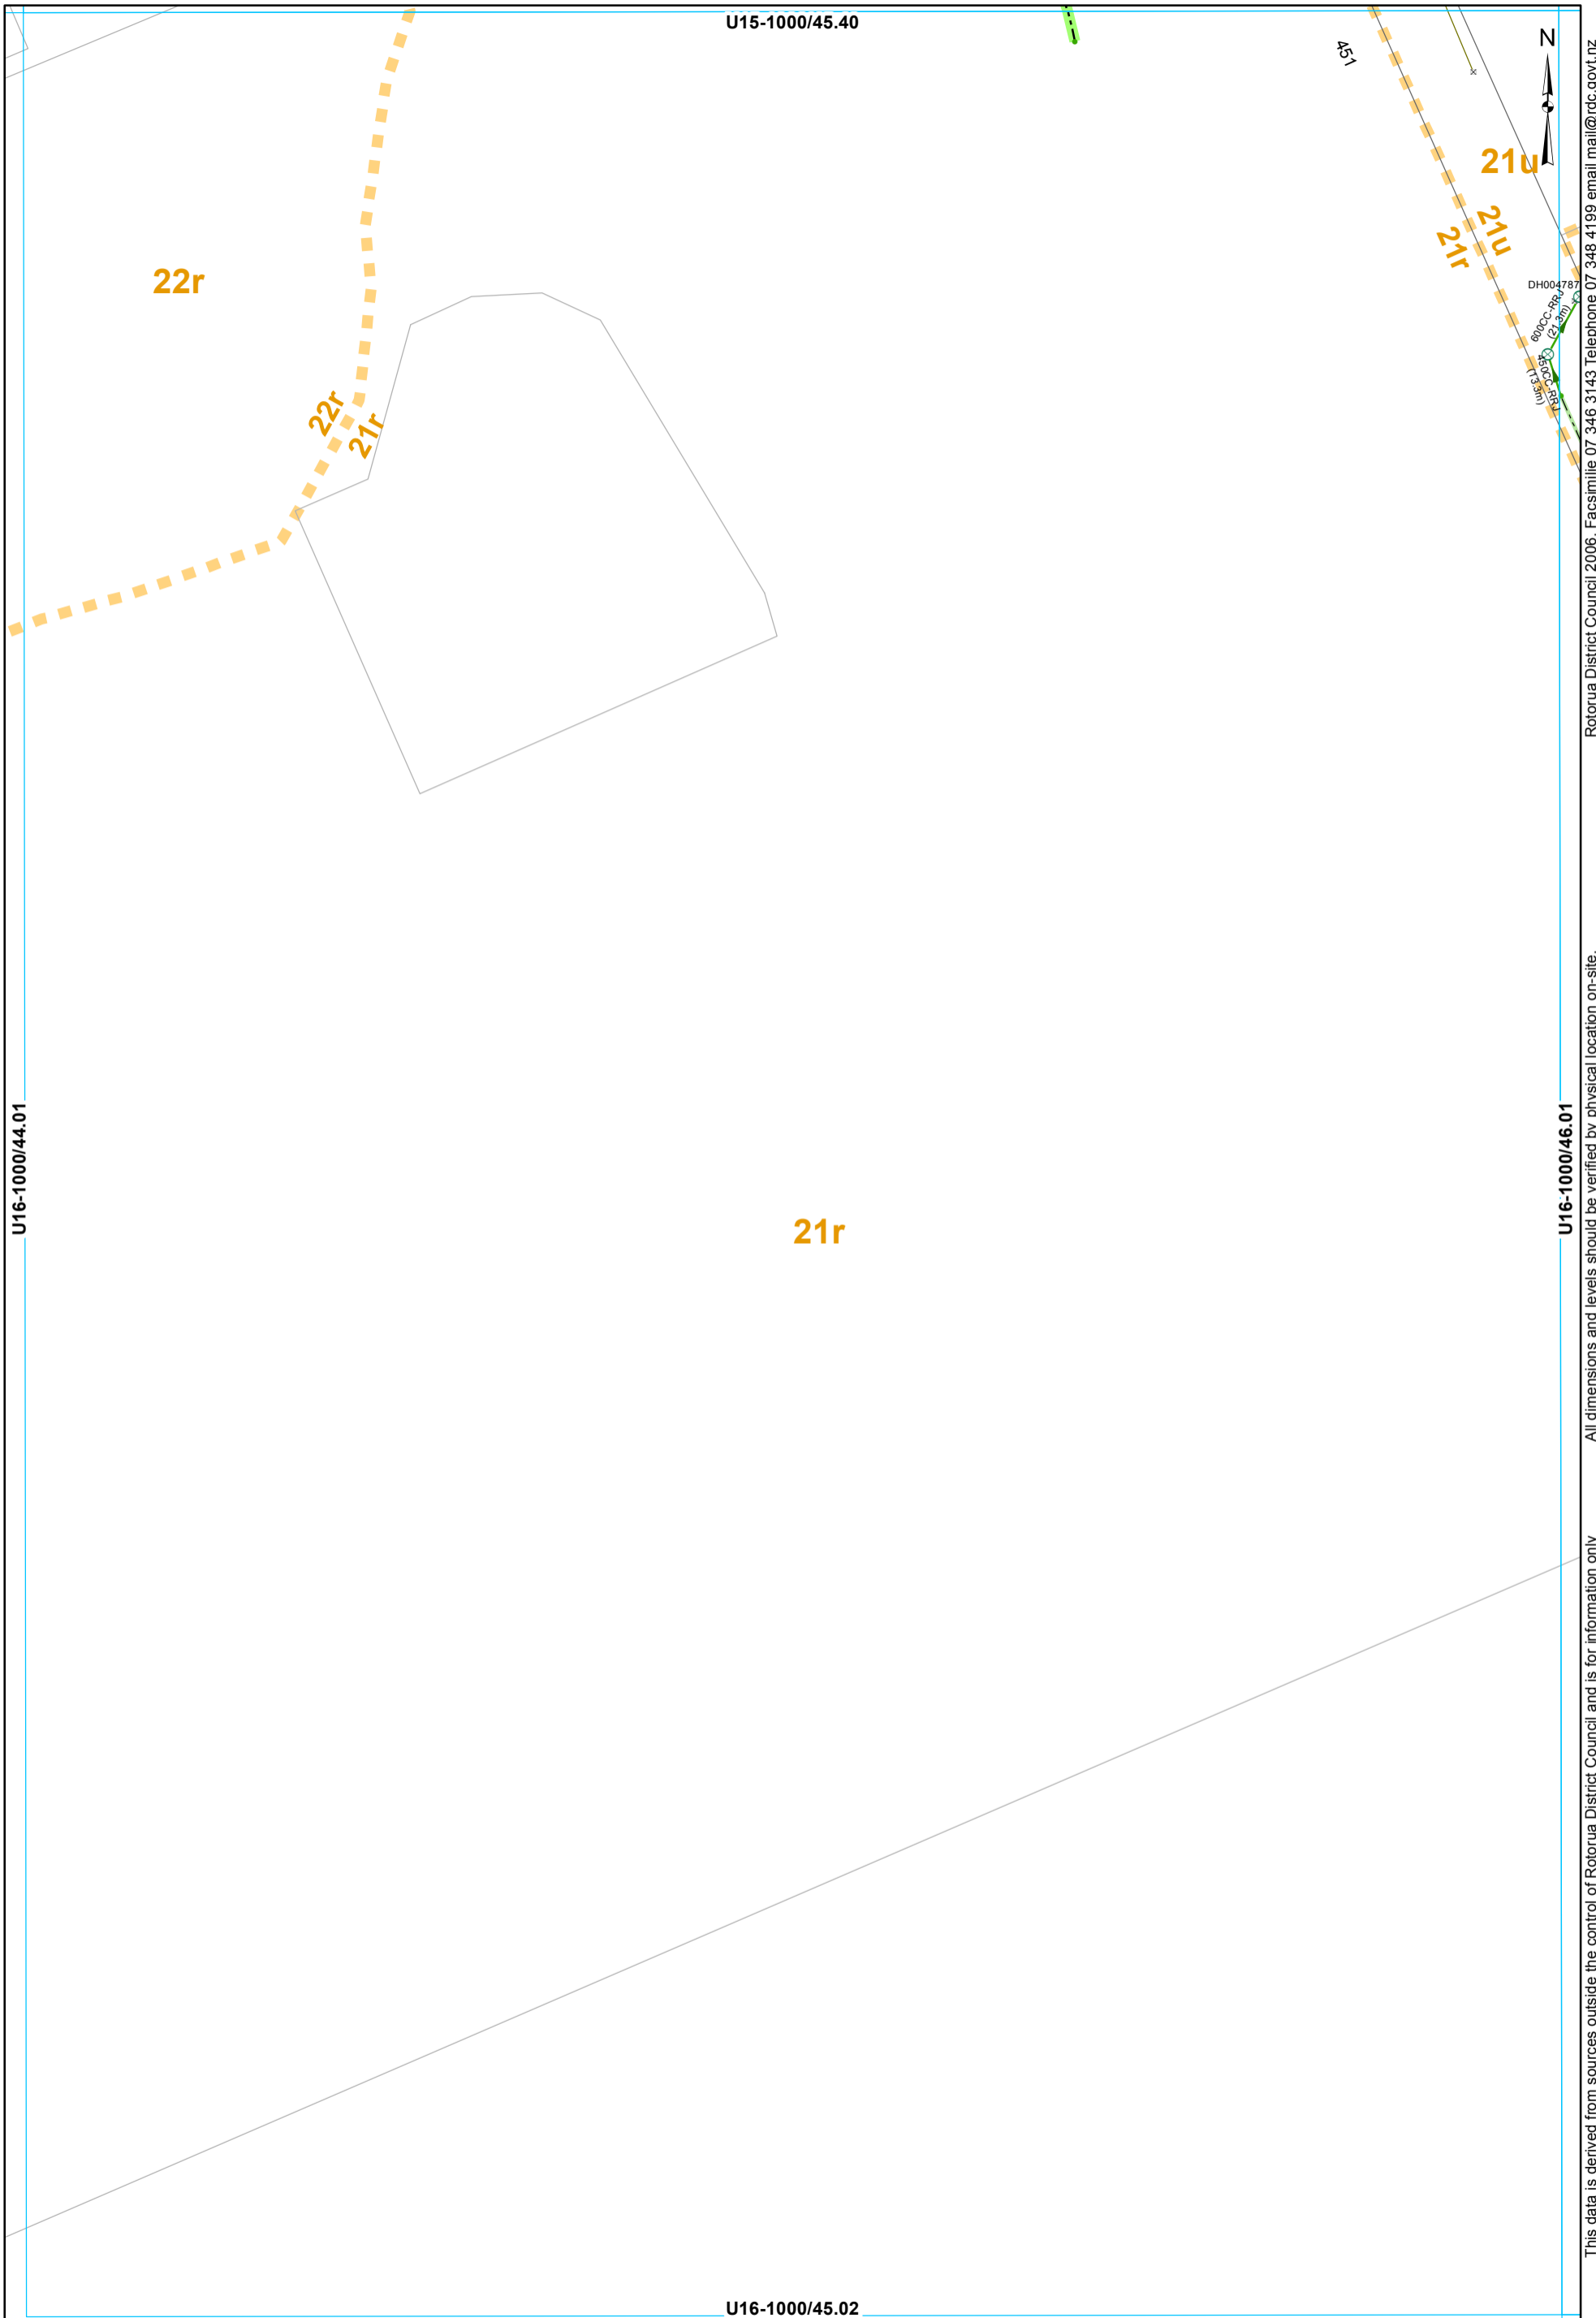


- ⊗ SWManhole
- × SWInlet
- Node
- Open Drain
- Stream
- Gravity Main
- SWLead
- Catchment Boundary

STORMWATER SERVICES
 1:2000 @ A3 - (U16-1000/45.01)

This data is derived from sources outside the control of Rotorua District Council and is for information only

Rotorua District Council 2006. Facsimile 07 346 3143 Telephone 07 348 4199 email mail@rdc.govt.nz

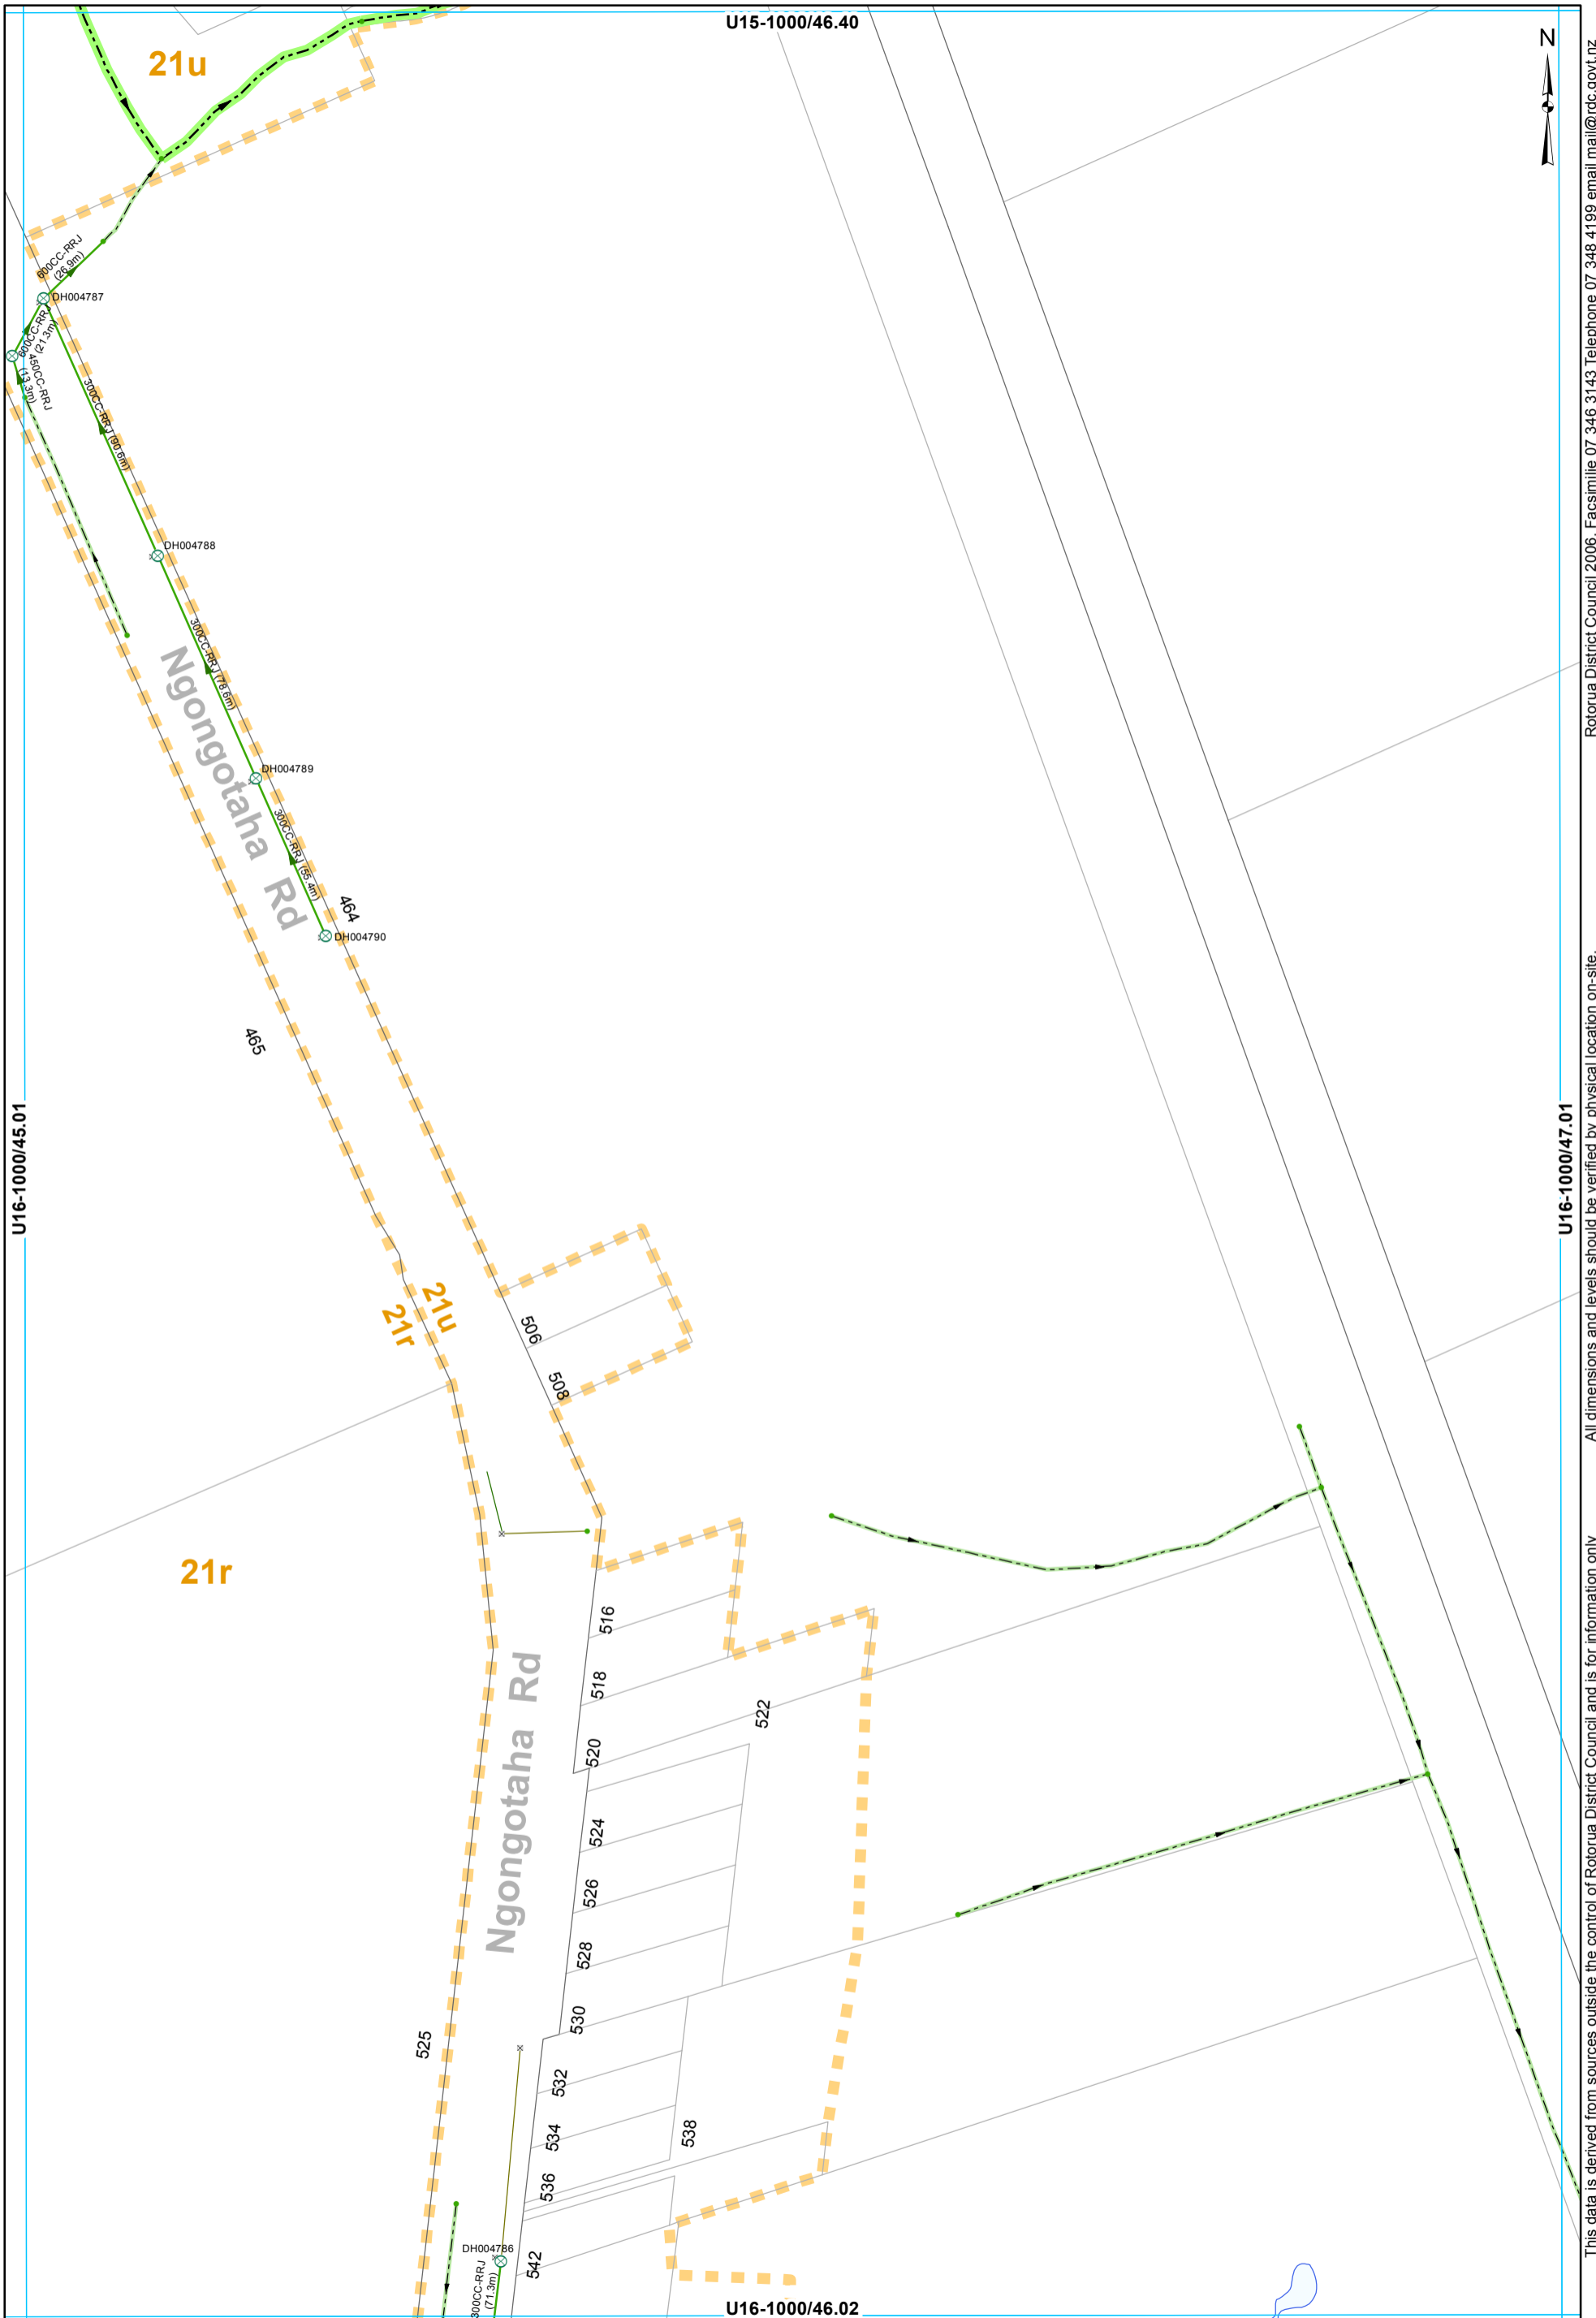

- ⊗ SWManhole
- × SWInlet
- Node
- Open Drain
- Stream
- Gravity Main
- SWServiceline
- SWLead
- Catchment Boundary

STORMWATER SERVICES
1:2000 @ A3 - (U16-1000/46.01)

This data is derived from sources outside the control of Rotorua District Council and is for information only

All dimensions and levels should be verified by physical location on-site.


Rotorua District Council 2006. Facsimile 07 346 3143 Telephone 07 348 4199 email mail@rdc.govt.nz

U16-1000/45.01

U16-1000/47.01

U15-1000/46.40

U16-1000/46.02

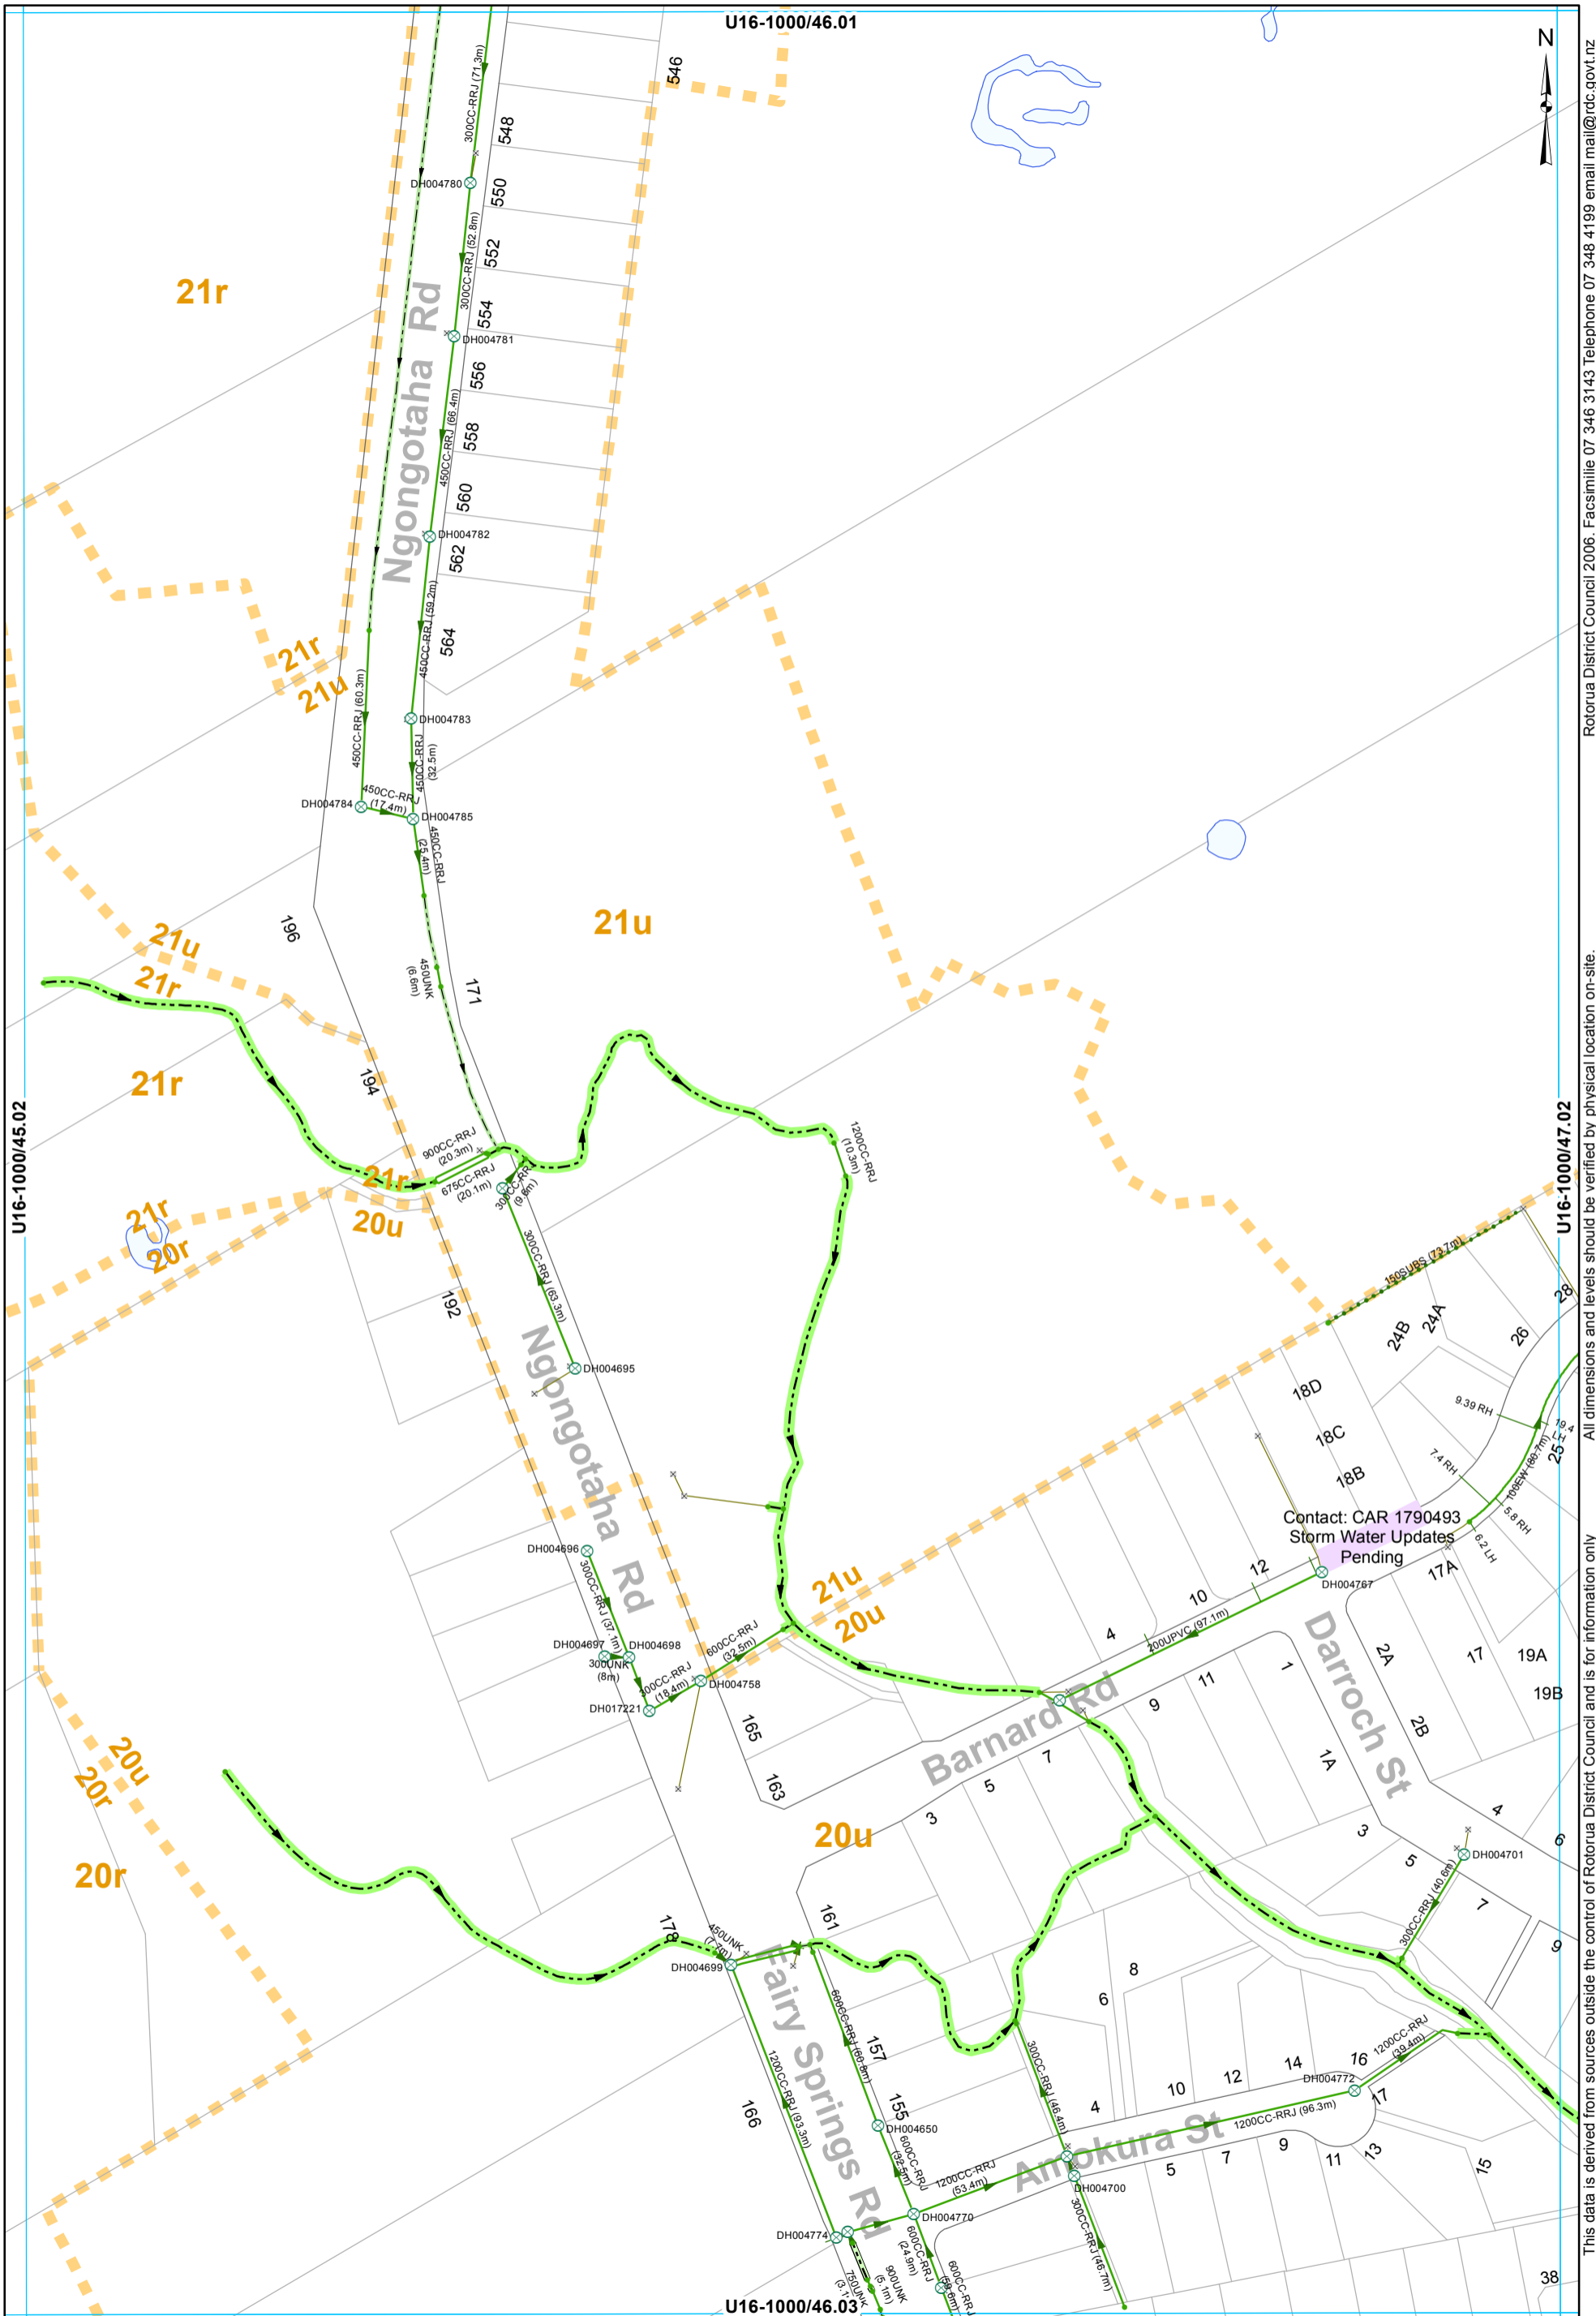

- ⊗ SWManhole
- × SWInlet
- Node
- ▬ Lined Channel
- ▬ Open Drain
- ▬ Stream
- ▬ Culvert
- ▬ Gravity Main
- ▬ Subsoil Drain
- ▬ SWServiceline
- ▬ SWServiceline
- ▬ SWLead
- ▬ Catchment Boundary

STORMWATER SERVICES
1:2000 @ A3 - (U16-1000/46.02)

This data is derived from sources outside the control of Rotorua District Council and is for information only

Rotorua District Council 2006. Facsimile 07 346 3143 Telephone 07 348 4199 email mail@rdc.govt.nz