


Storm Water Asbuilt Sheet Index

SWCatchment 23u

Compiled on 2021-06-15 from as-builts of various dates. For up to date as-builts please visit [http://geo.rdc.govt.nz/images/plotfiles/3waters\\_mobile\\_asbuilts/](http://geo.rdc.govt.nz/images/plotfiles/3waters_mobile_asbuilts/)

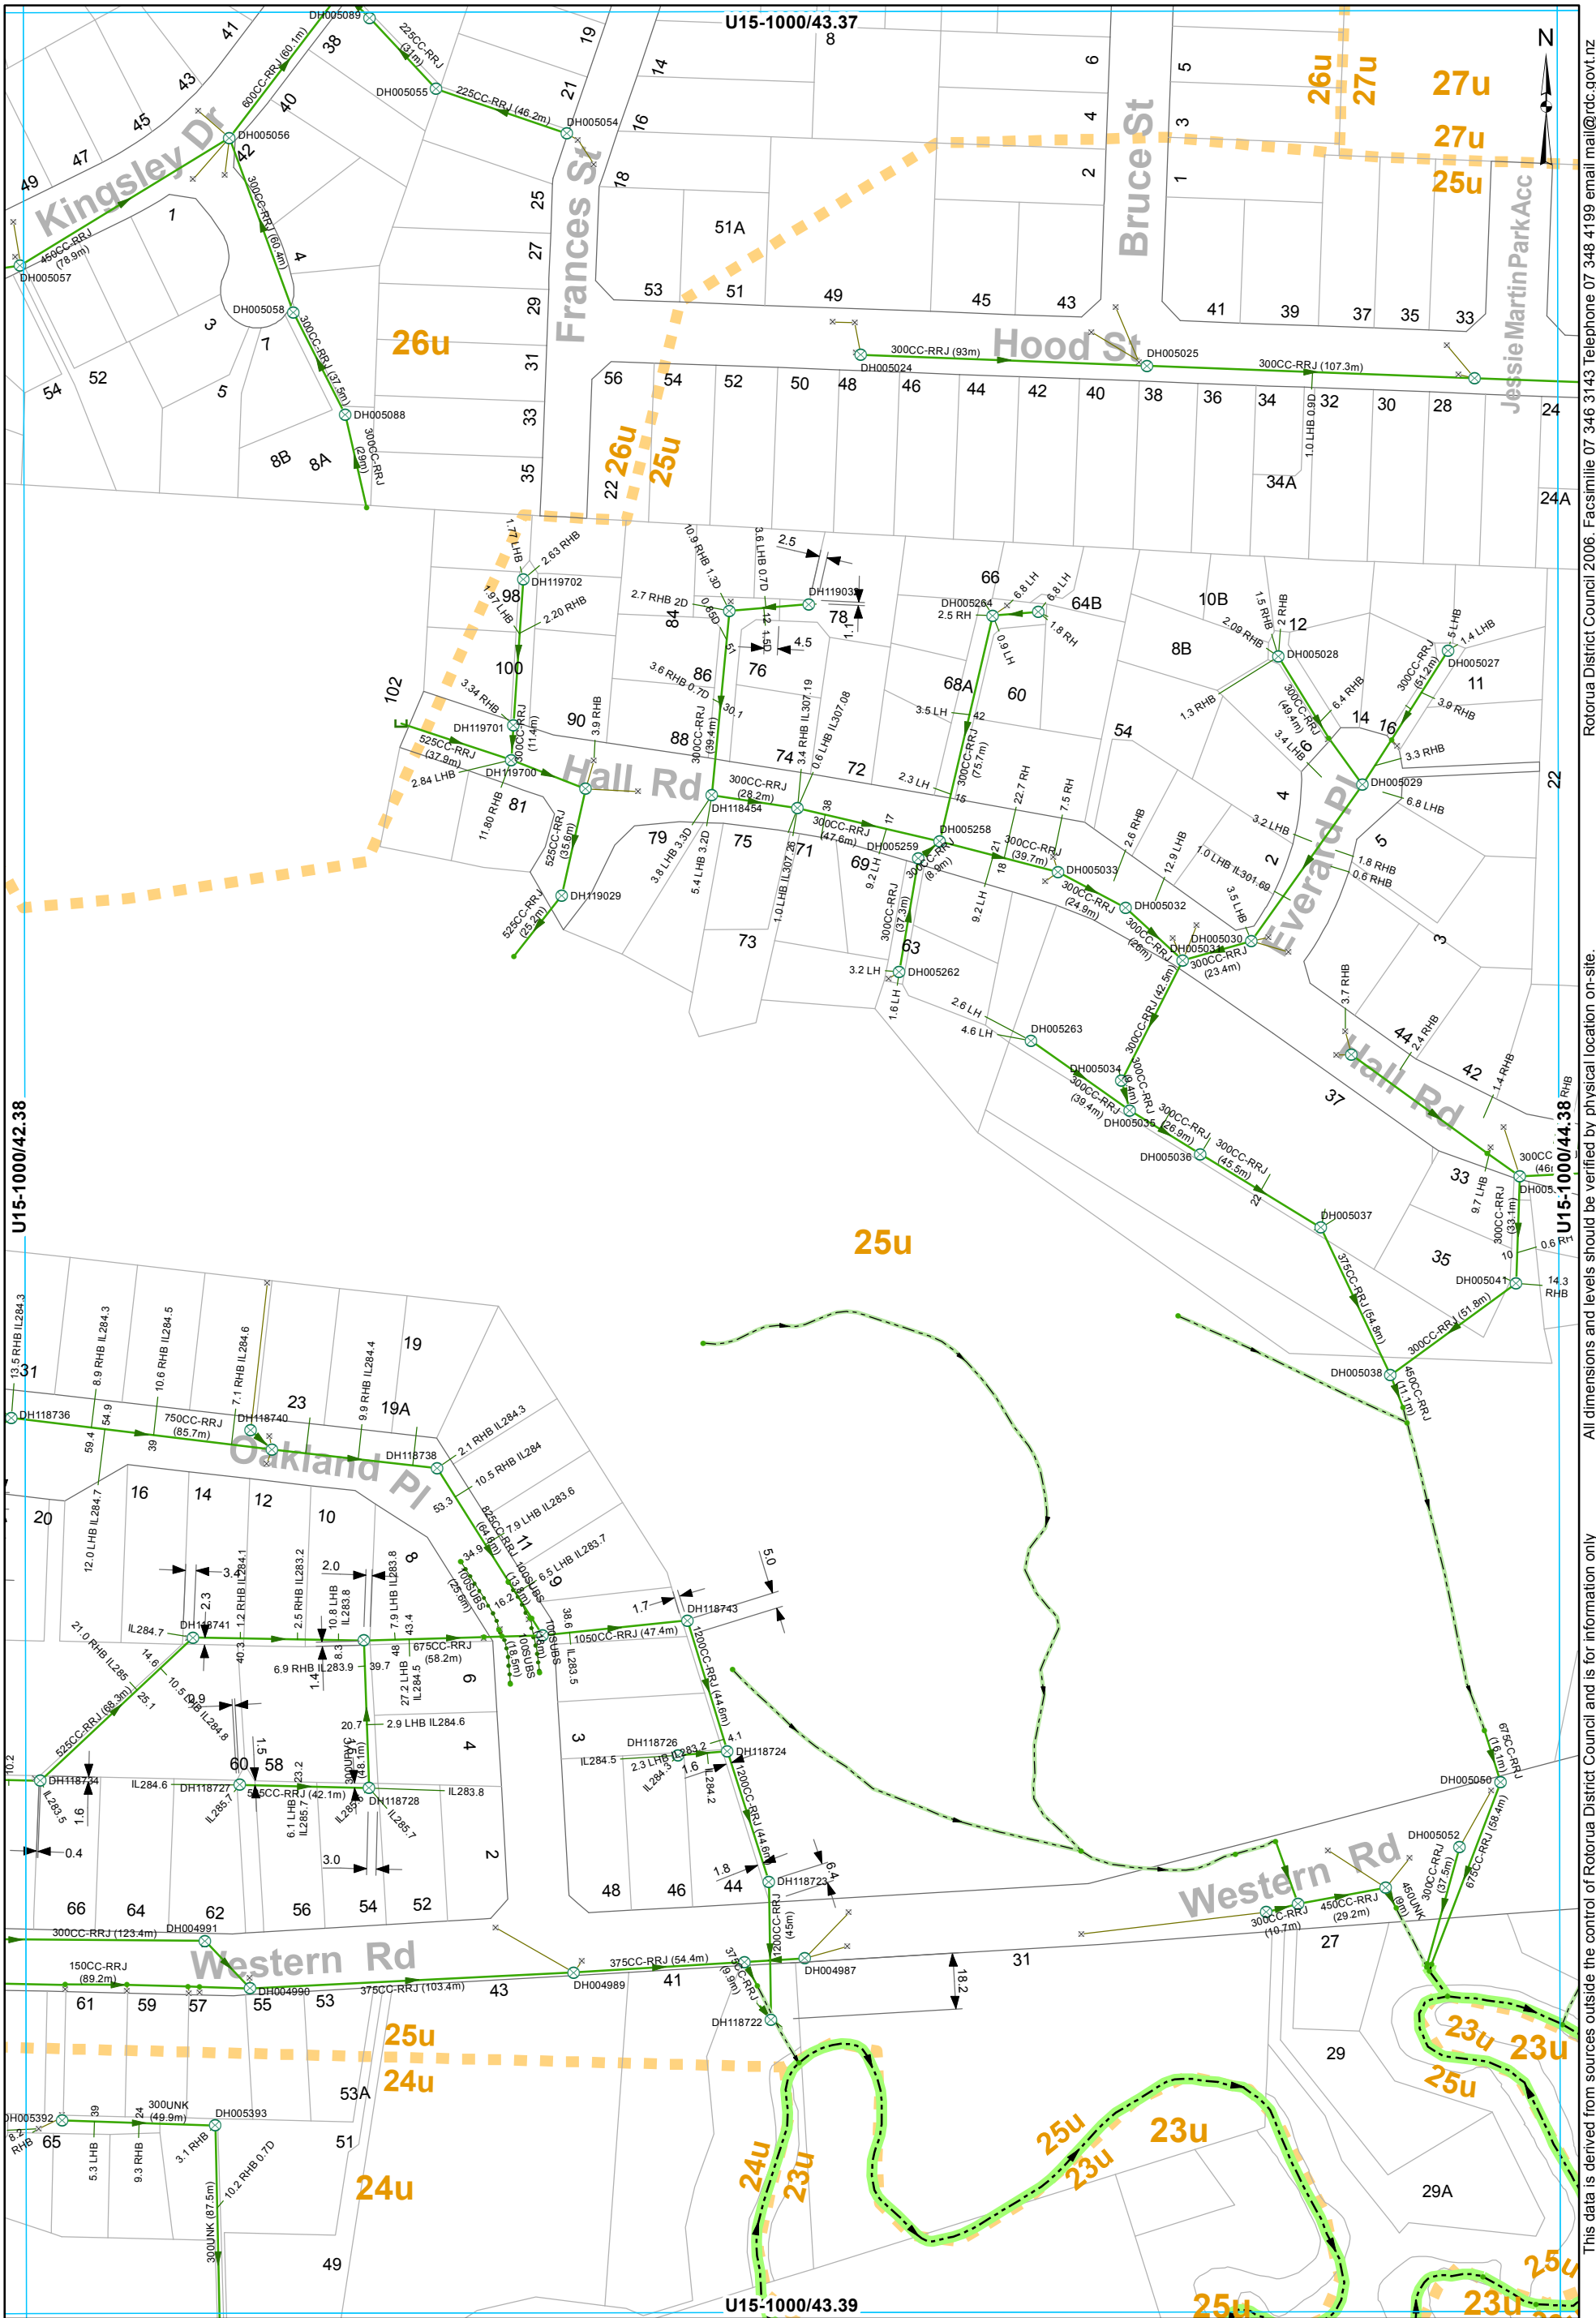


- ⊗ SWManhole
- × SWInlet
- Node
- ┌ Capped End
- └ Headwall Structure
- Open Drain
- Stream
- Gravity Main
- ⋯ Subsoil Drain
- SWServiceline
- SWServiceline
- SWLead
- Catchment Boundary

**STORMWATER SERVICES**  
**1:2000 @ A3 - (U15-1000/43.38)**

This data is derived from sources outside the control of Rotorua District Council and is for information only

All dimensions and levels should be verified by physical location on-site.

Rotorua District Council 2006. Facsimile 07 346 3143 Telephone 07 348 4199 email mail@rdc.govt.nz

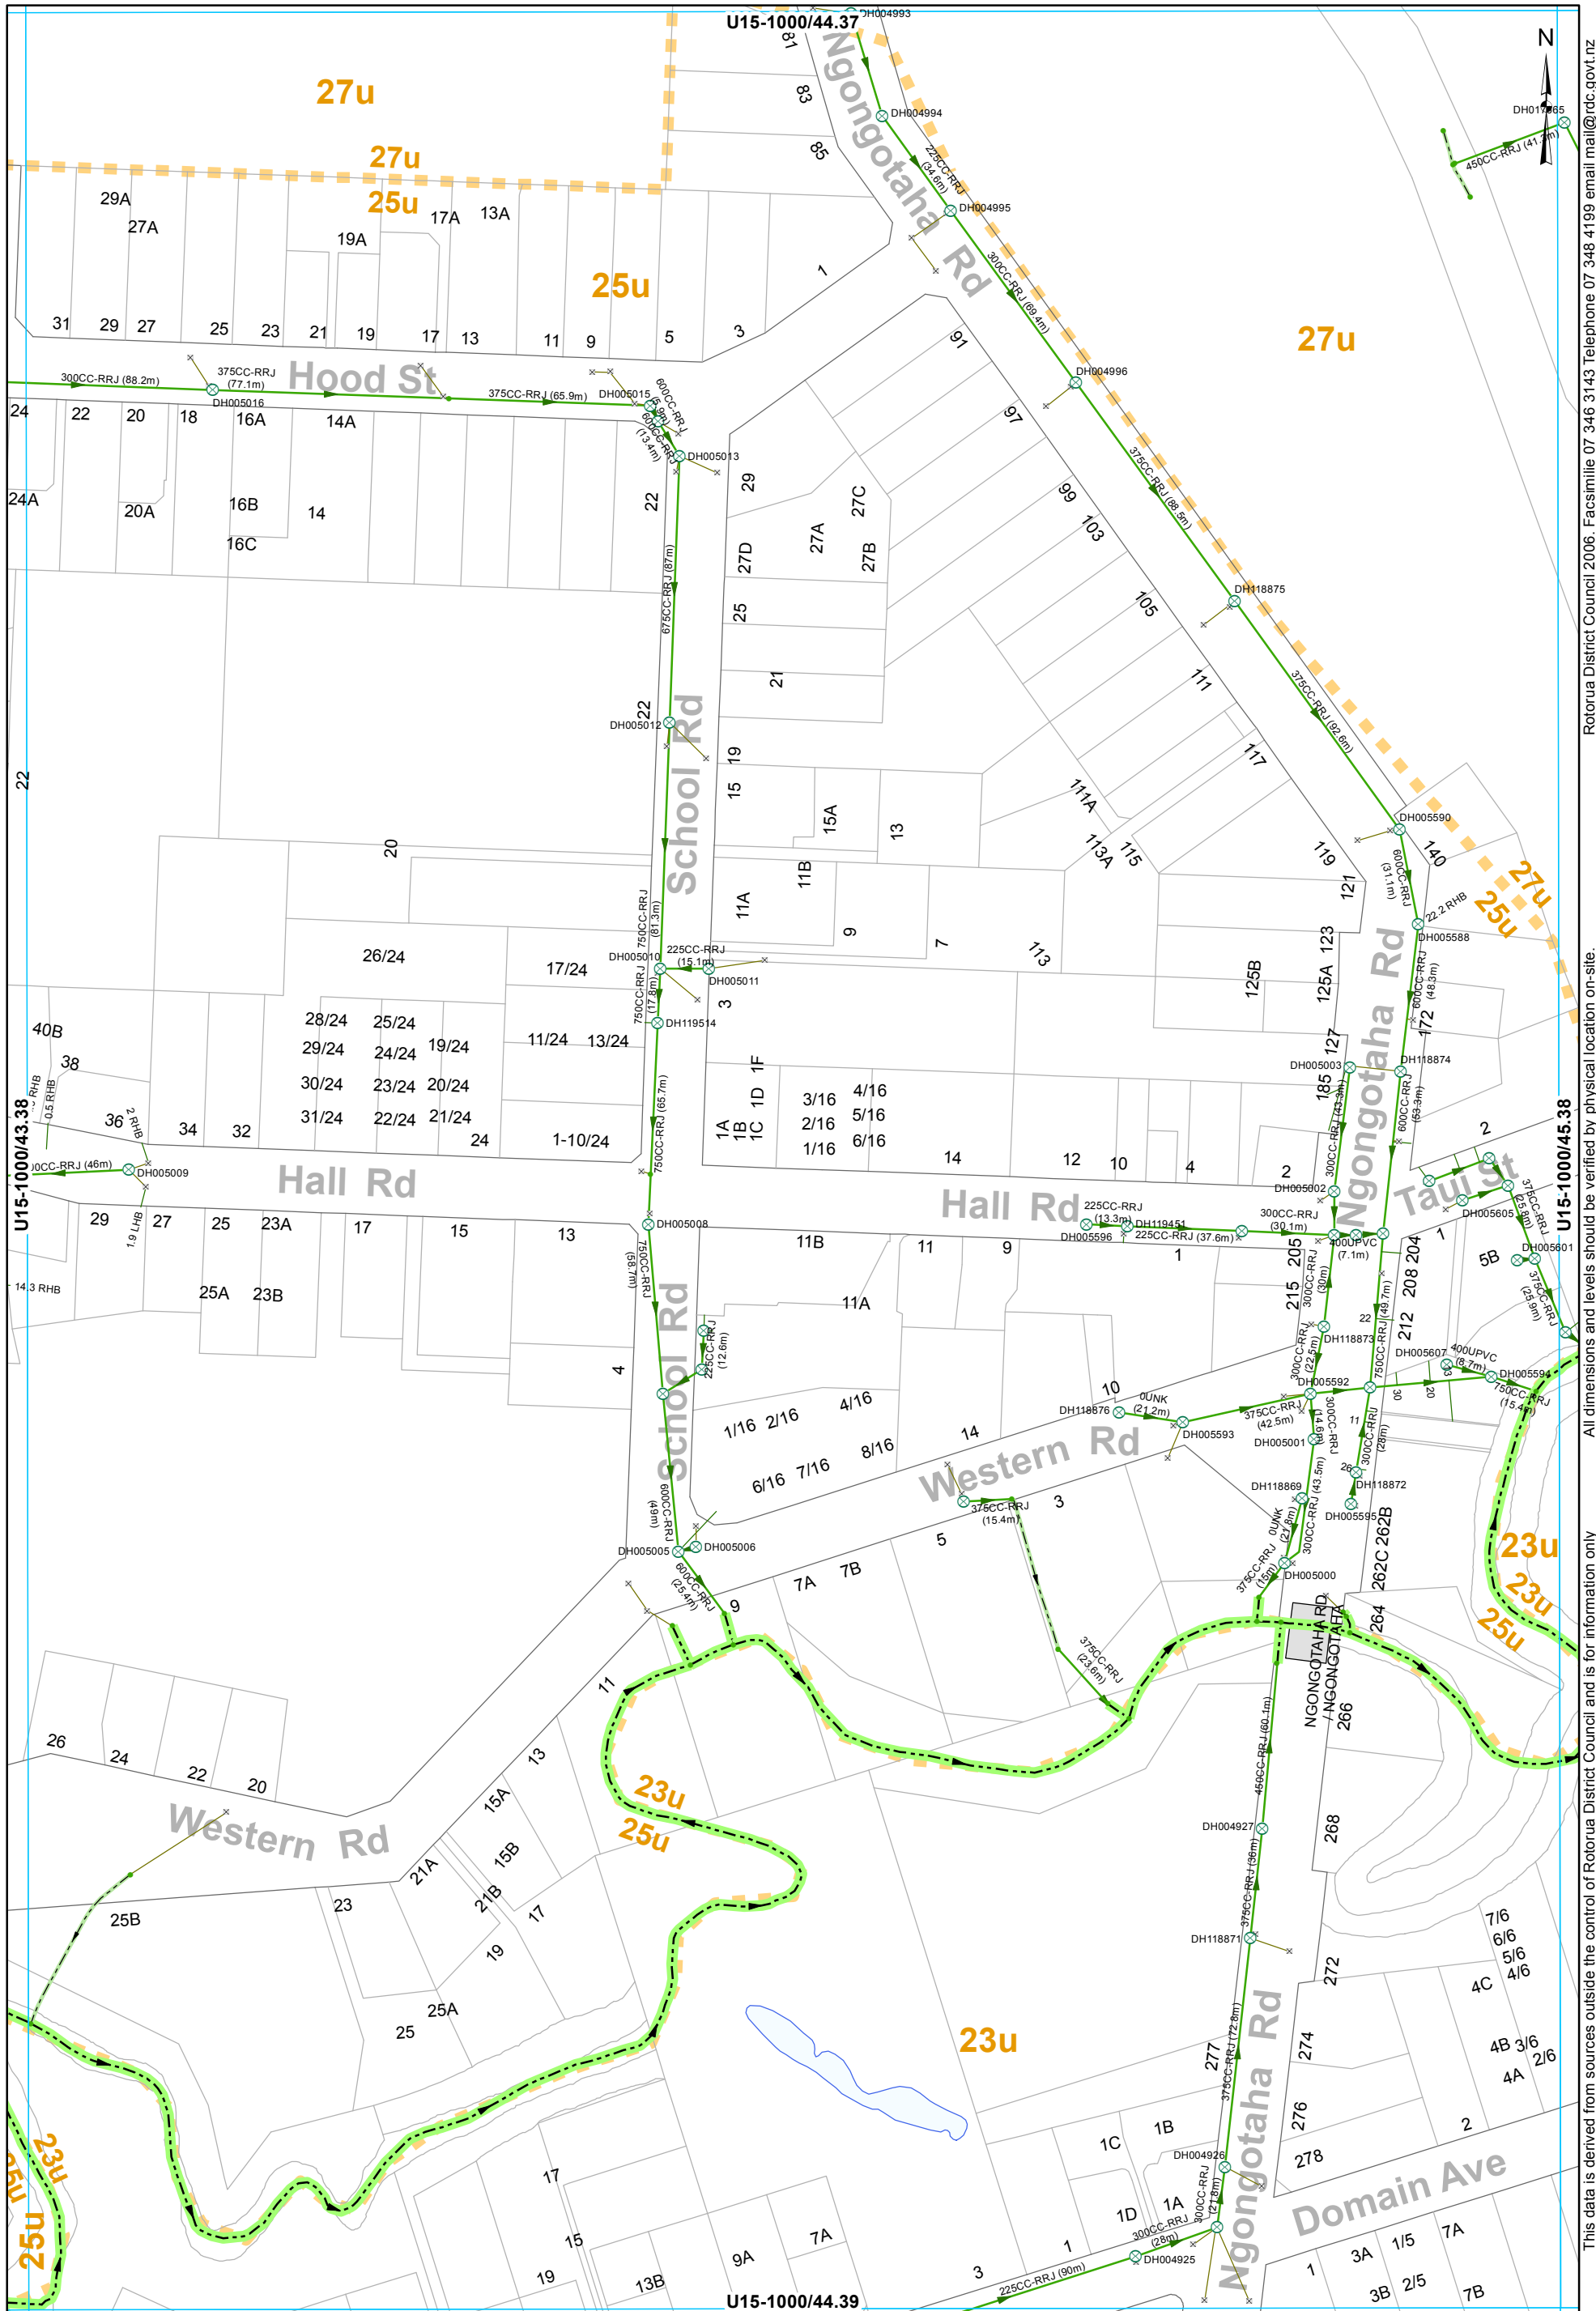

- ⊗ SWManhole
- × SWInlet
- Node
- Open Drain
- Stream
- Culvert
- Gravity Main
- SWServiceline
- SWServiceline
- SWLead
- Catchment Boundary

**STORMWATER SERVICES**  
**1:2000 @ A3 - (U15-1000/44.38)**

This data is derived from sources outside the control of Rotorua District Council and is for information only


All dimensions and levels should be verified by physical location on-site.

Rotorua District Council 2006. Facsimile 07 346 3143 Telephone 07 348 4199 email mail@rdc.govt.nz

U15-1000/46.37



Lake Rotorua

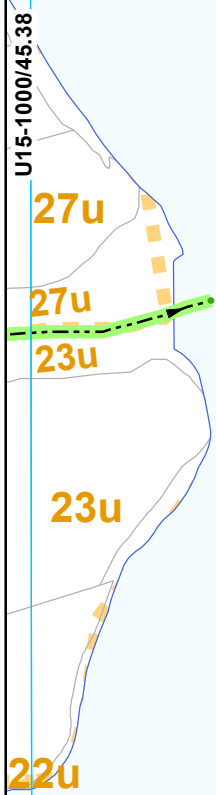


U15-1000/47.38

This data is derived from sources outside the control of Rotorua District Council and is for information only. All dimensions and levels should be verified by physical location on-site.

U15-1000/46.39

- Node
- Stream
- ▭ Catchment Boundary



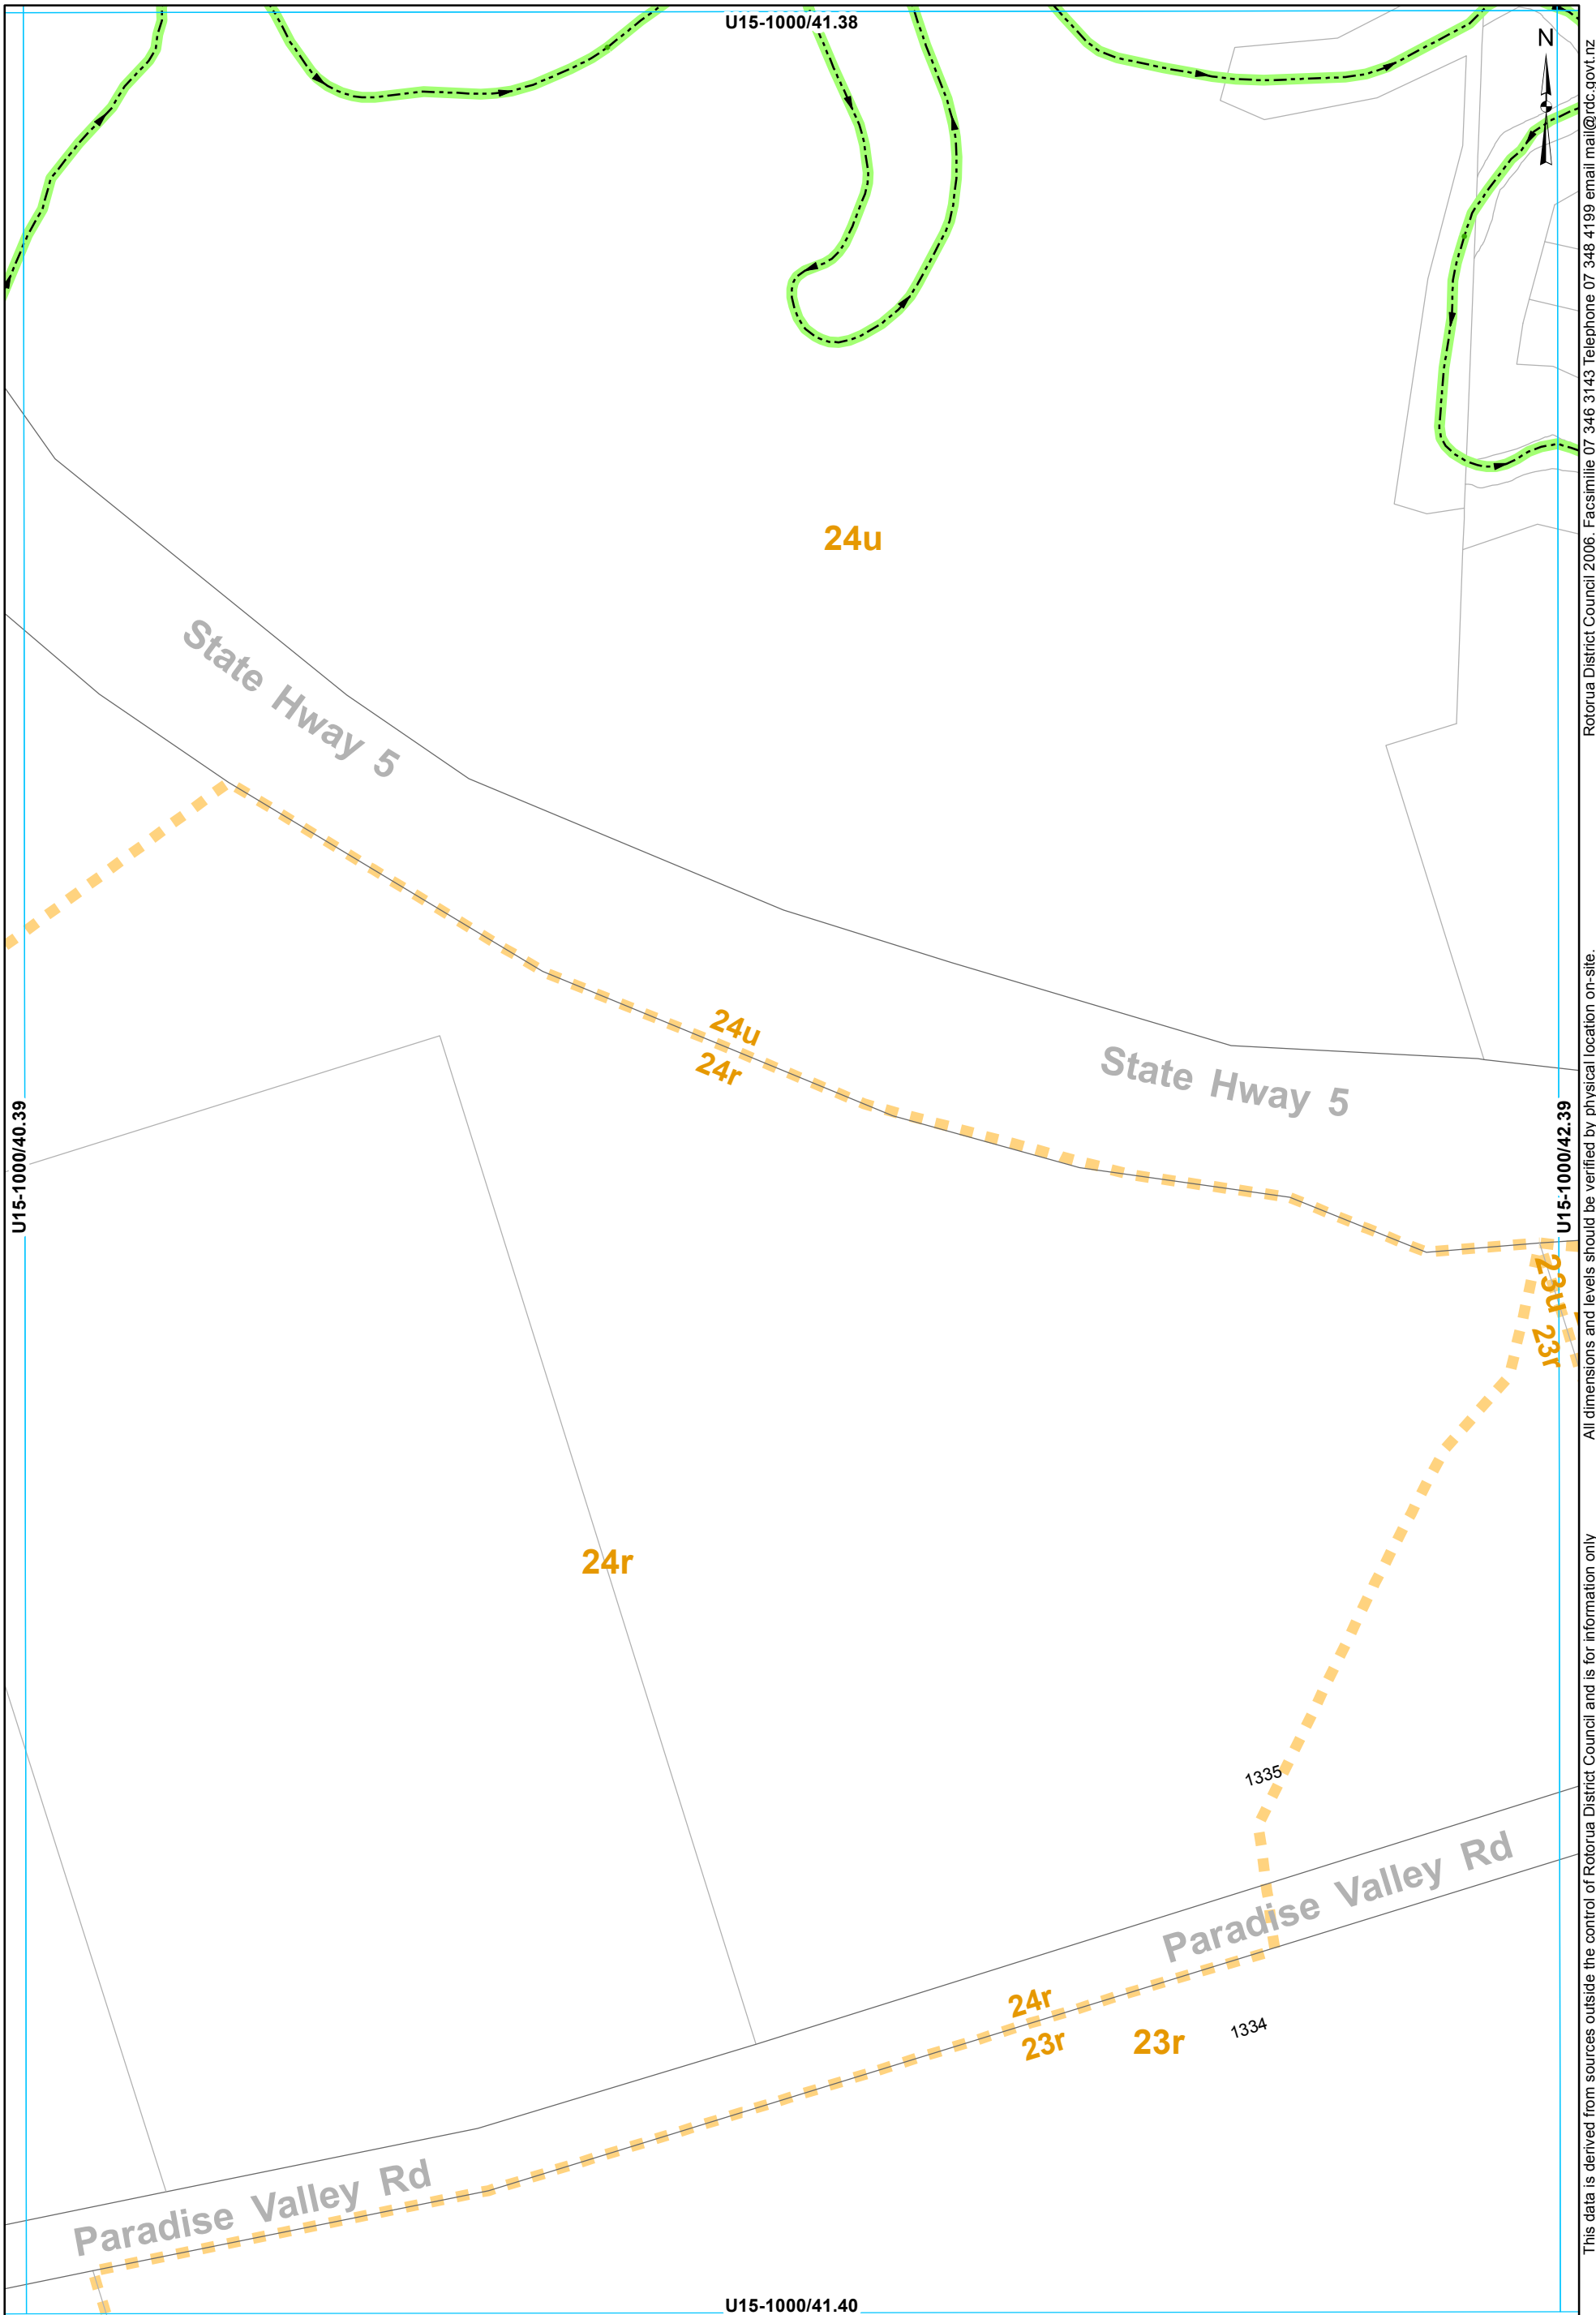


- Node
- Stream
- Catchment Boundary

**STORMWATER SERVICES**  
 1:2000 @ A3 - (U15-1000/41.39)

This data is derived from sources outside the control of Rotorua District Council and is for information only

All dimensions and levels should be verified by physical location on-site.

Rotorua District Council 2006. Facsimile 07 346 3143 Telephone 07 348 4199 email mail@rdc.govt.nz

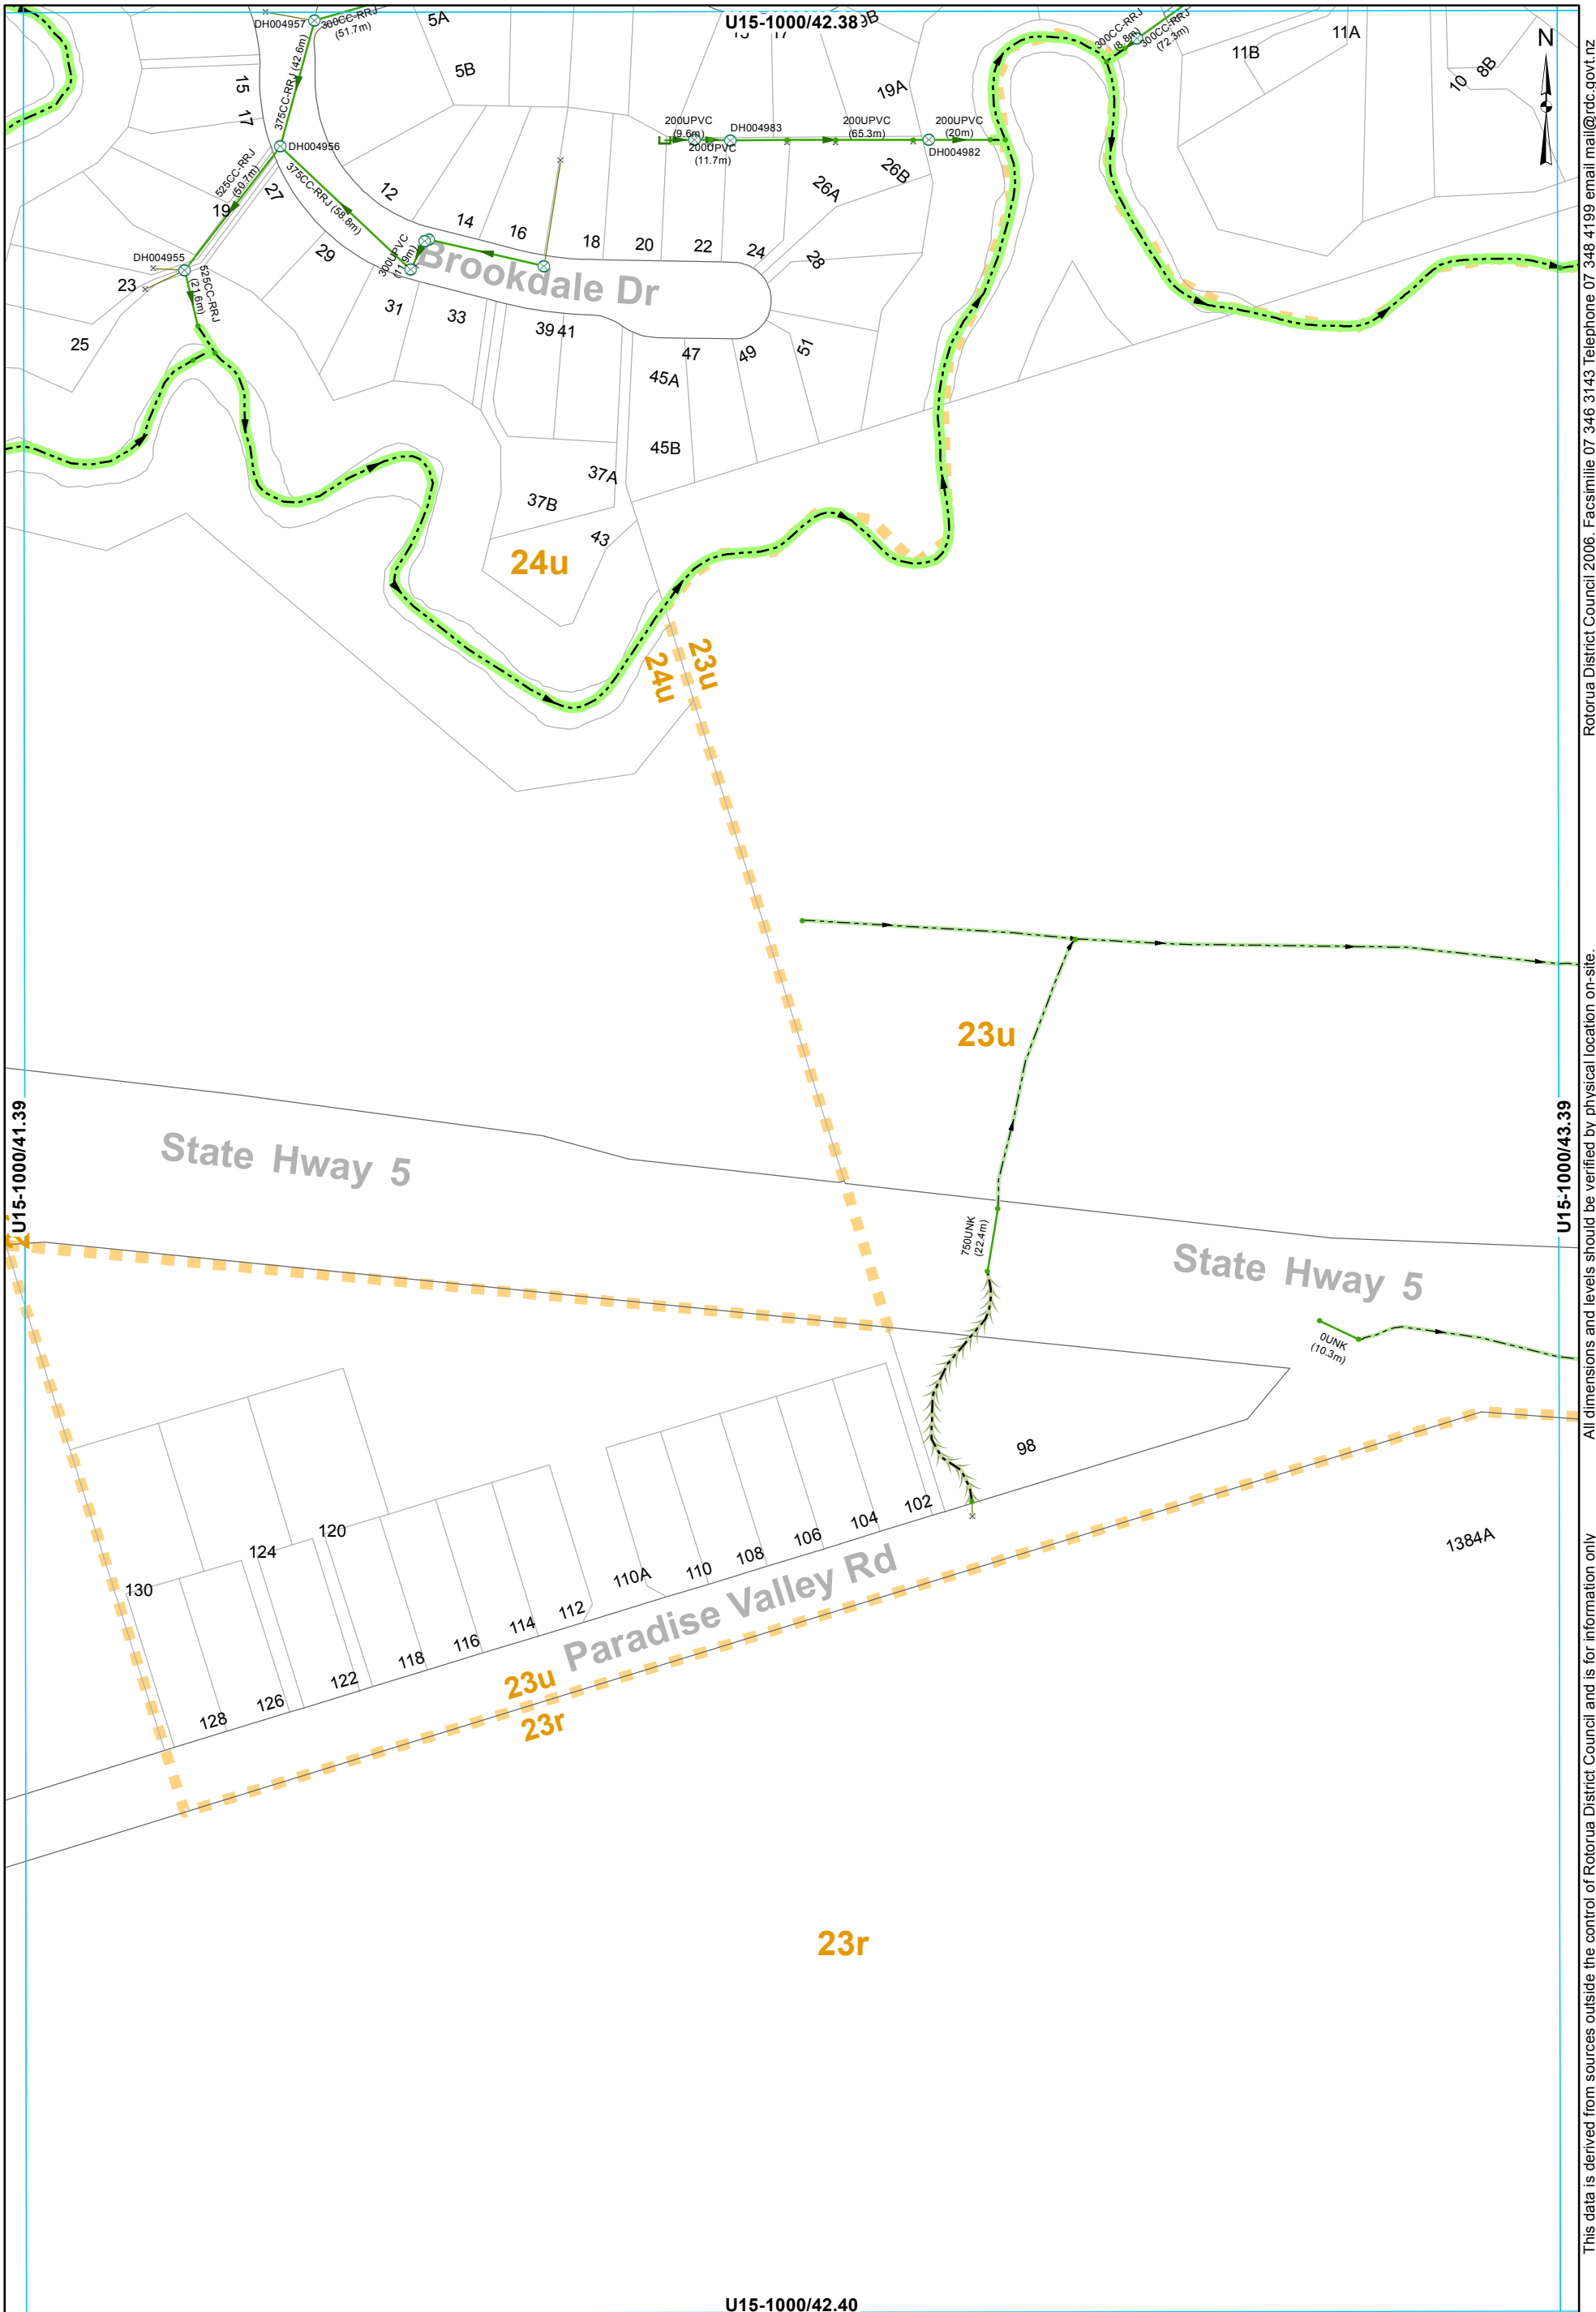

- ⊗ SWManhole
- × SWInlet
- Node
- ◻ Capped End
- Open Drain
- ... Overland Flow
- Stream
- Culvert
- Gravity Main
- SWLead
- ▬ Catchment Boundary


**STORMWATER SERVICES**  
**1:2000 @ A3 - (U15-1000/42.39)**

All dimensions and levels are verified by physical location on-site. Rotorua District Council 2006. Facsimile 07 346 3143 Telephone 07 348 4199 email mail@rdc.govt.nz

U15-1000/42.40

U15-1000/41.39

U15-1000/43.39

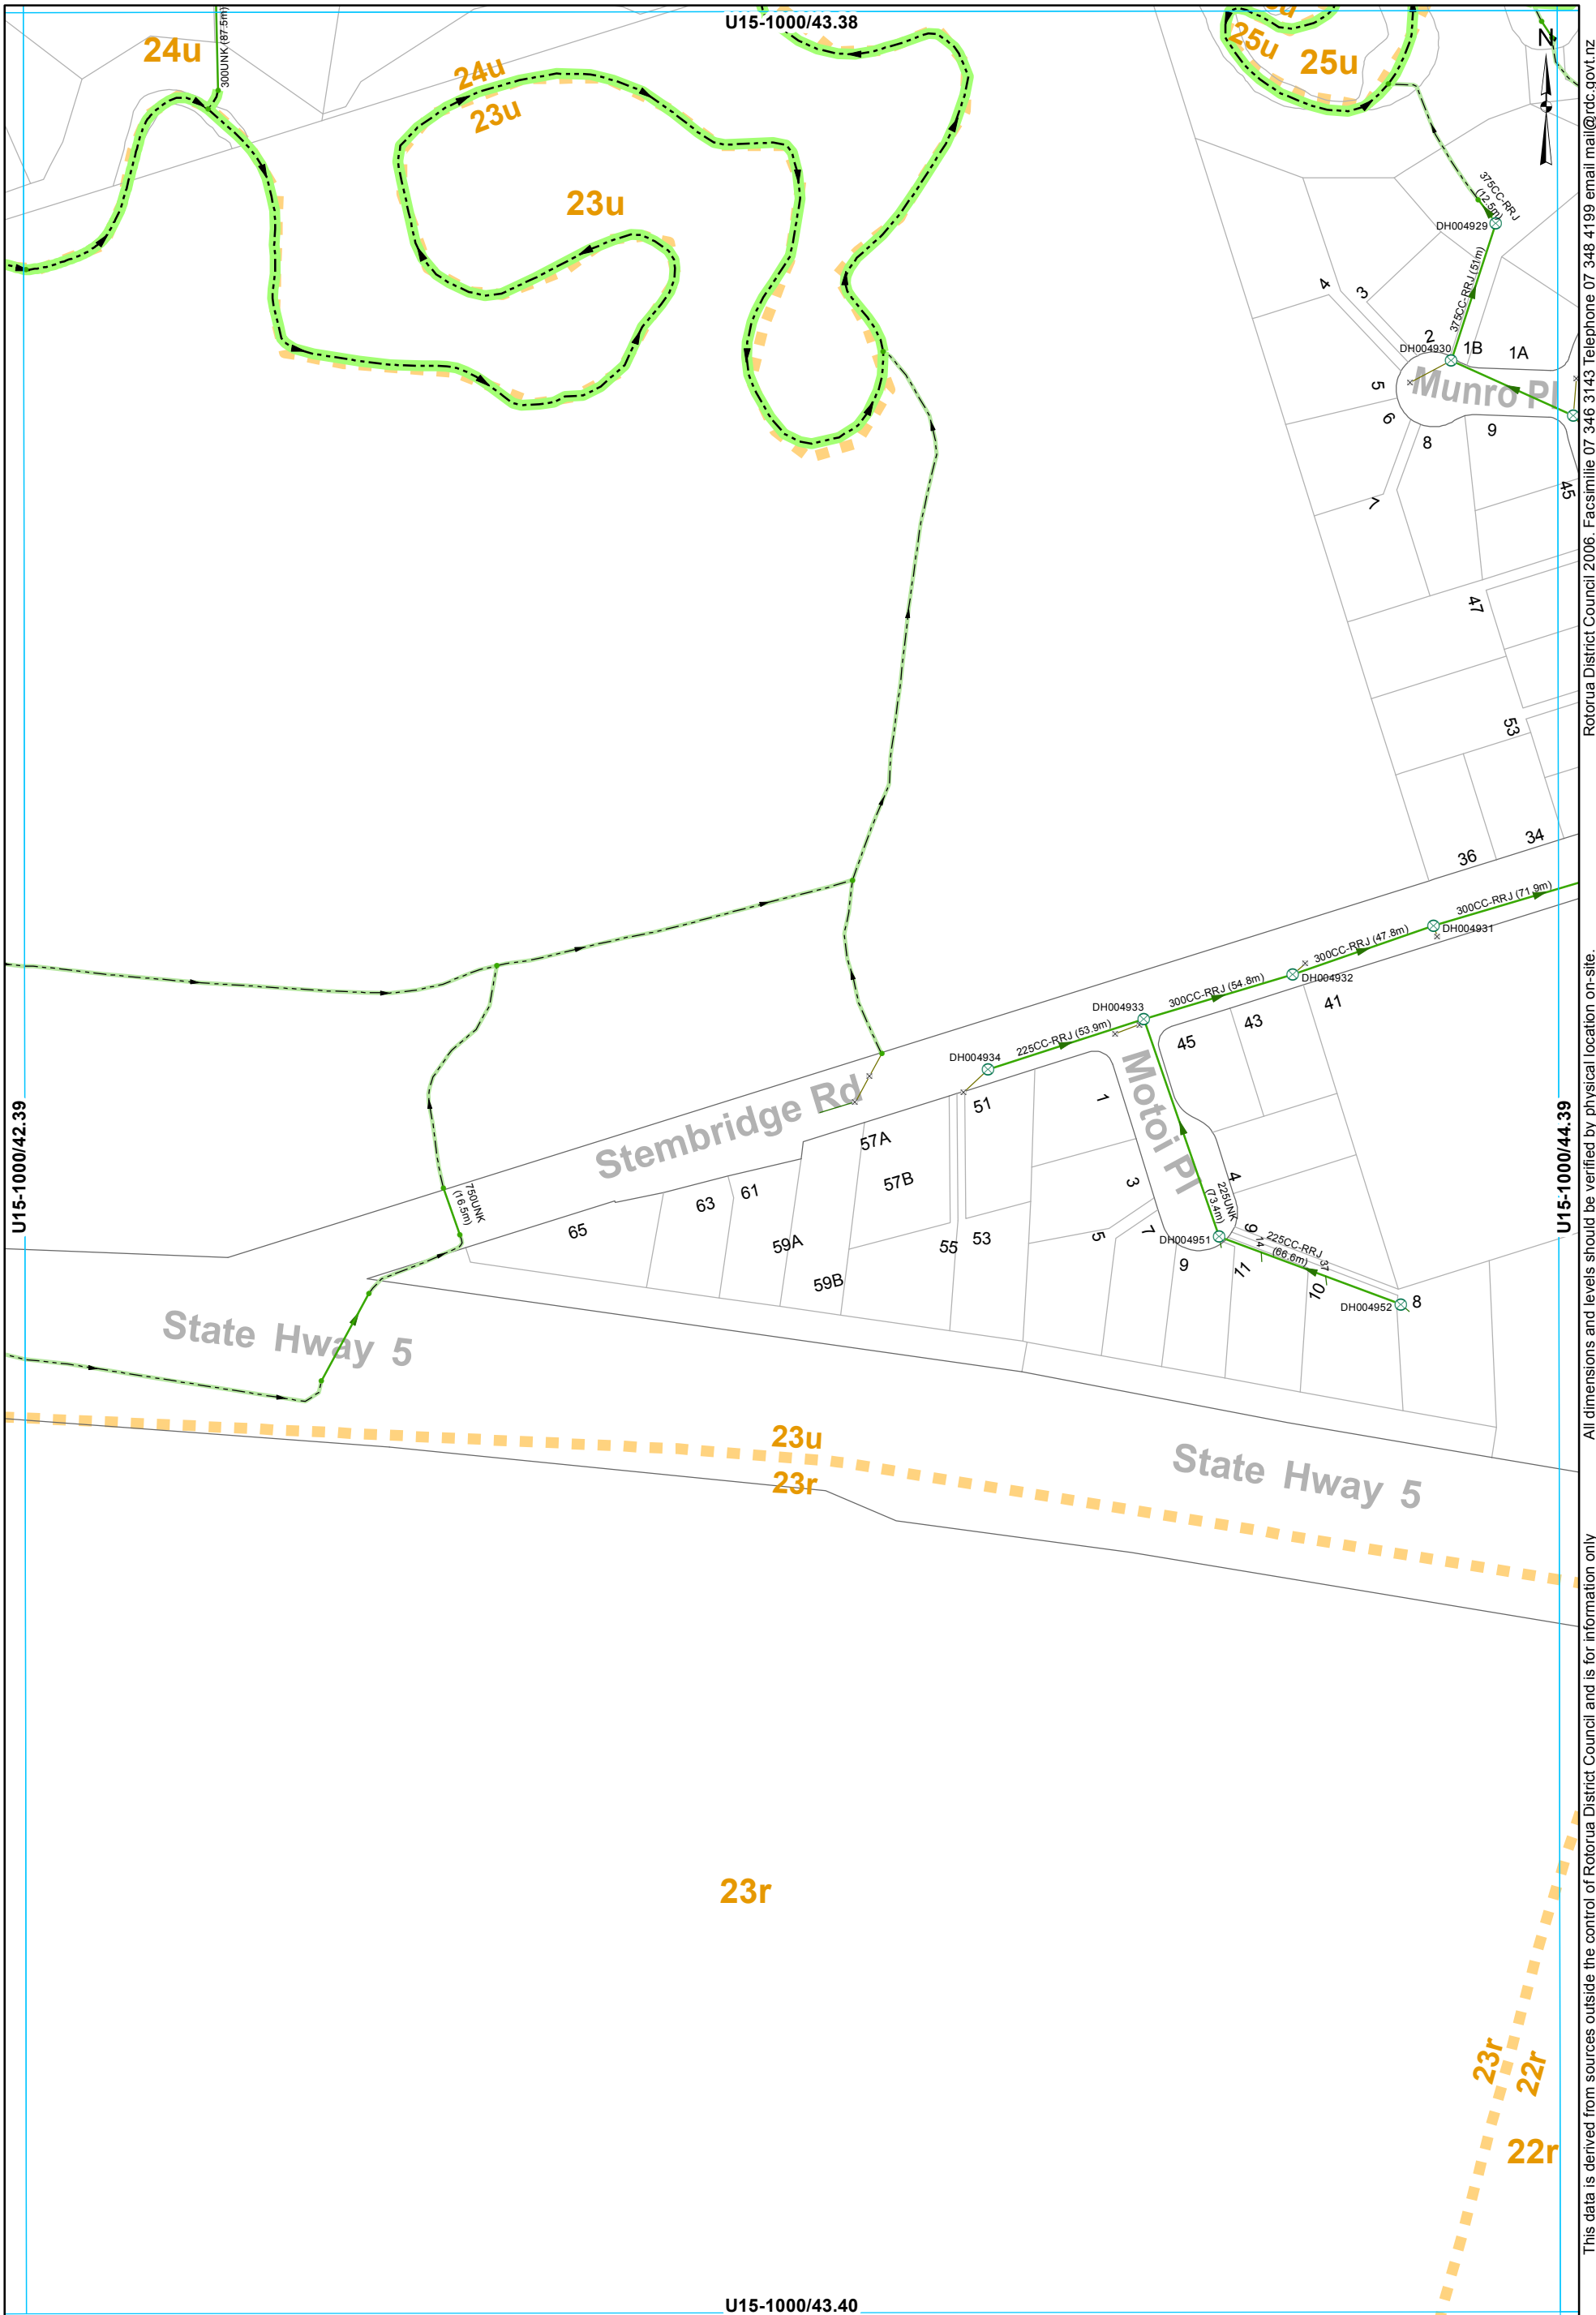


All dimensions and levels should be verified by physical location on-site.

Rotorua District Council 2006. Facsimile 07 346 3143 Telephone 07 348 4199 email mail@rdc.govt.nz

- ⊗ SWManhole
- × SWInlet
- Node
- Open Drain
- Stream
- Culvert
- Gravity Main
- SWServiceline
- SWServiceline
- SWLead
- Catchment Boundary

**STORMWATER SERVICES**  
1:2000 @ A3 - (U15-1000/43.39)

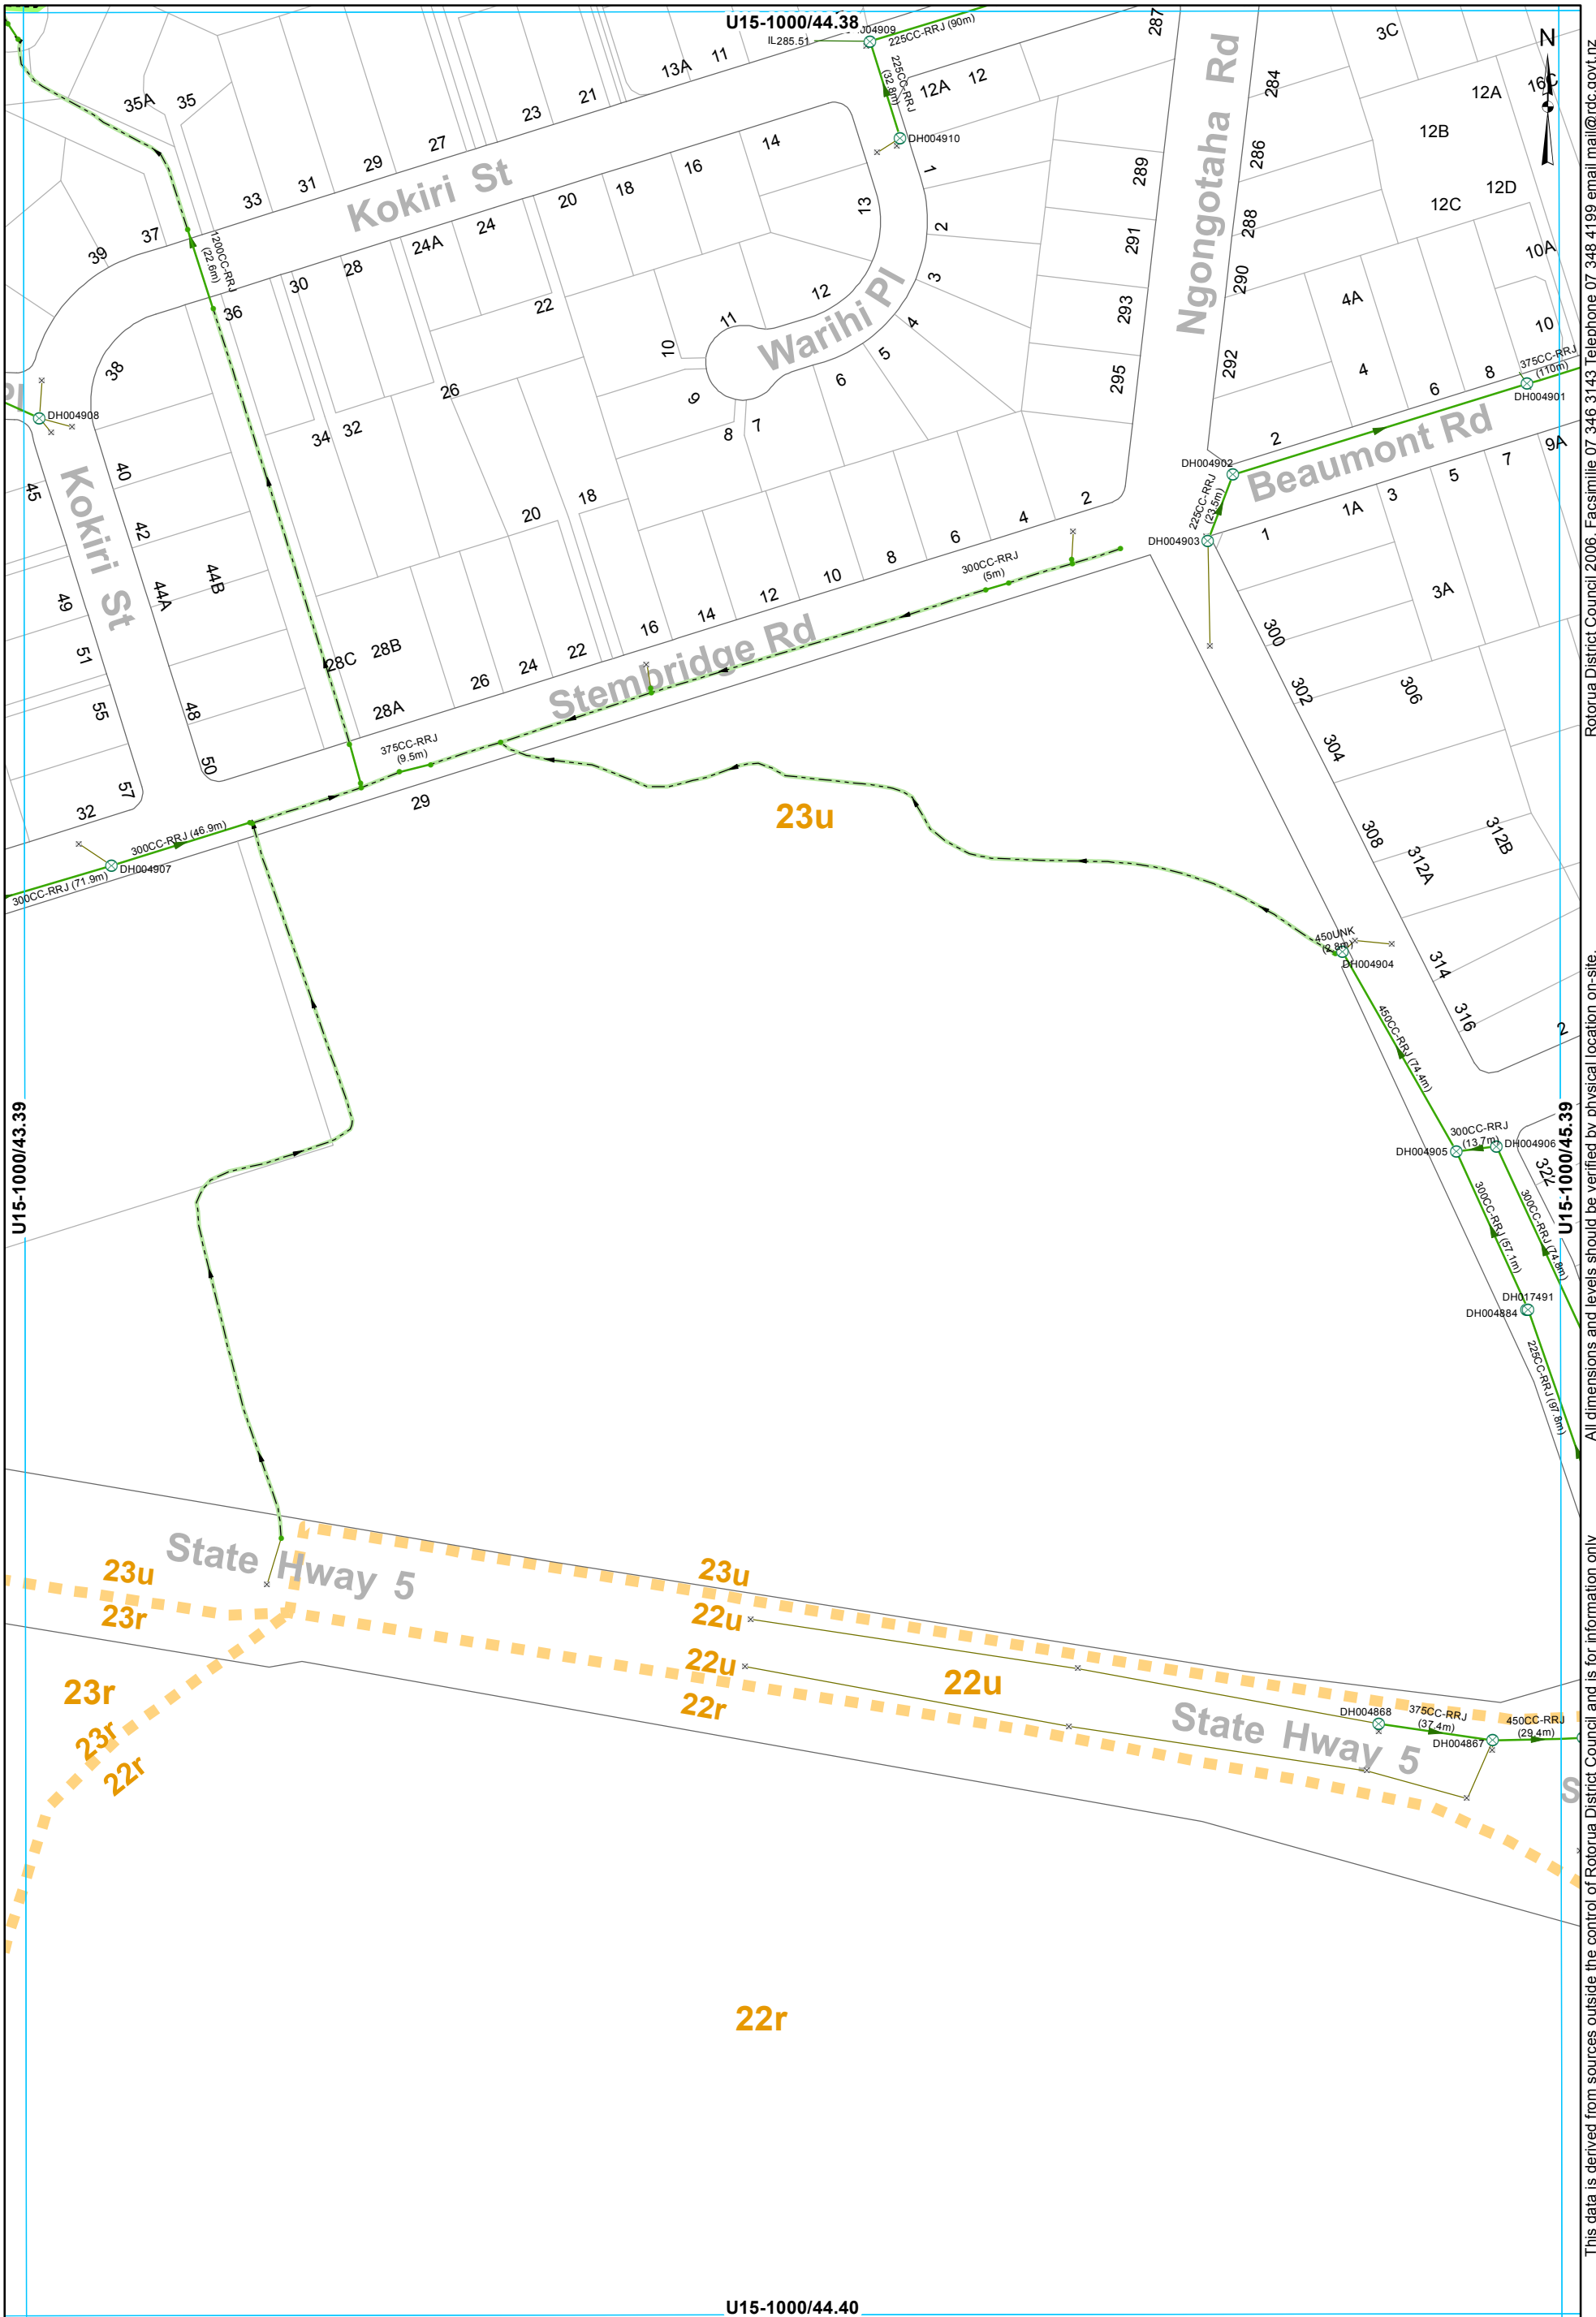

All dimensions and levels should be verified by physical location on-site. This data is derived from sources outside the control of Rotorua District Council and is for information only


Rotorua District Council 2006. Facsimile 07 348 3143 Telephone 07 348 4199 email mail@rdc.govt.nz

- ⊗ SWManhole
- × SWInlet
- Node
- Open Drain
- Stream
- Culvert
- Gravity Main
- SWServiceline
- SWServiceline
- SWLead
- Catchment Boundary

**STORMWATER SERVICES**  
1:2000 @ A3 - (U15-1000/44.39)

U15-1000/44.40



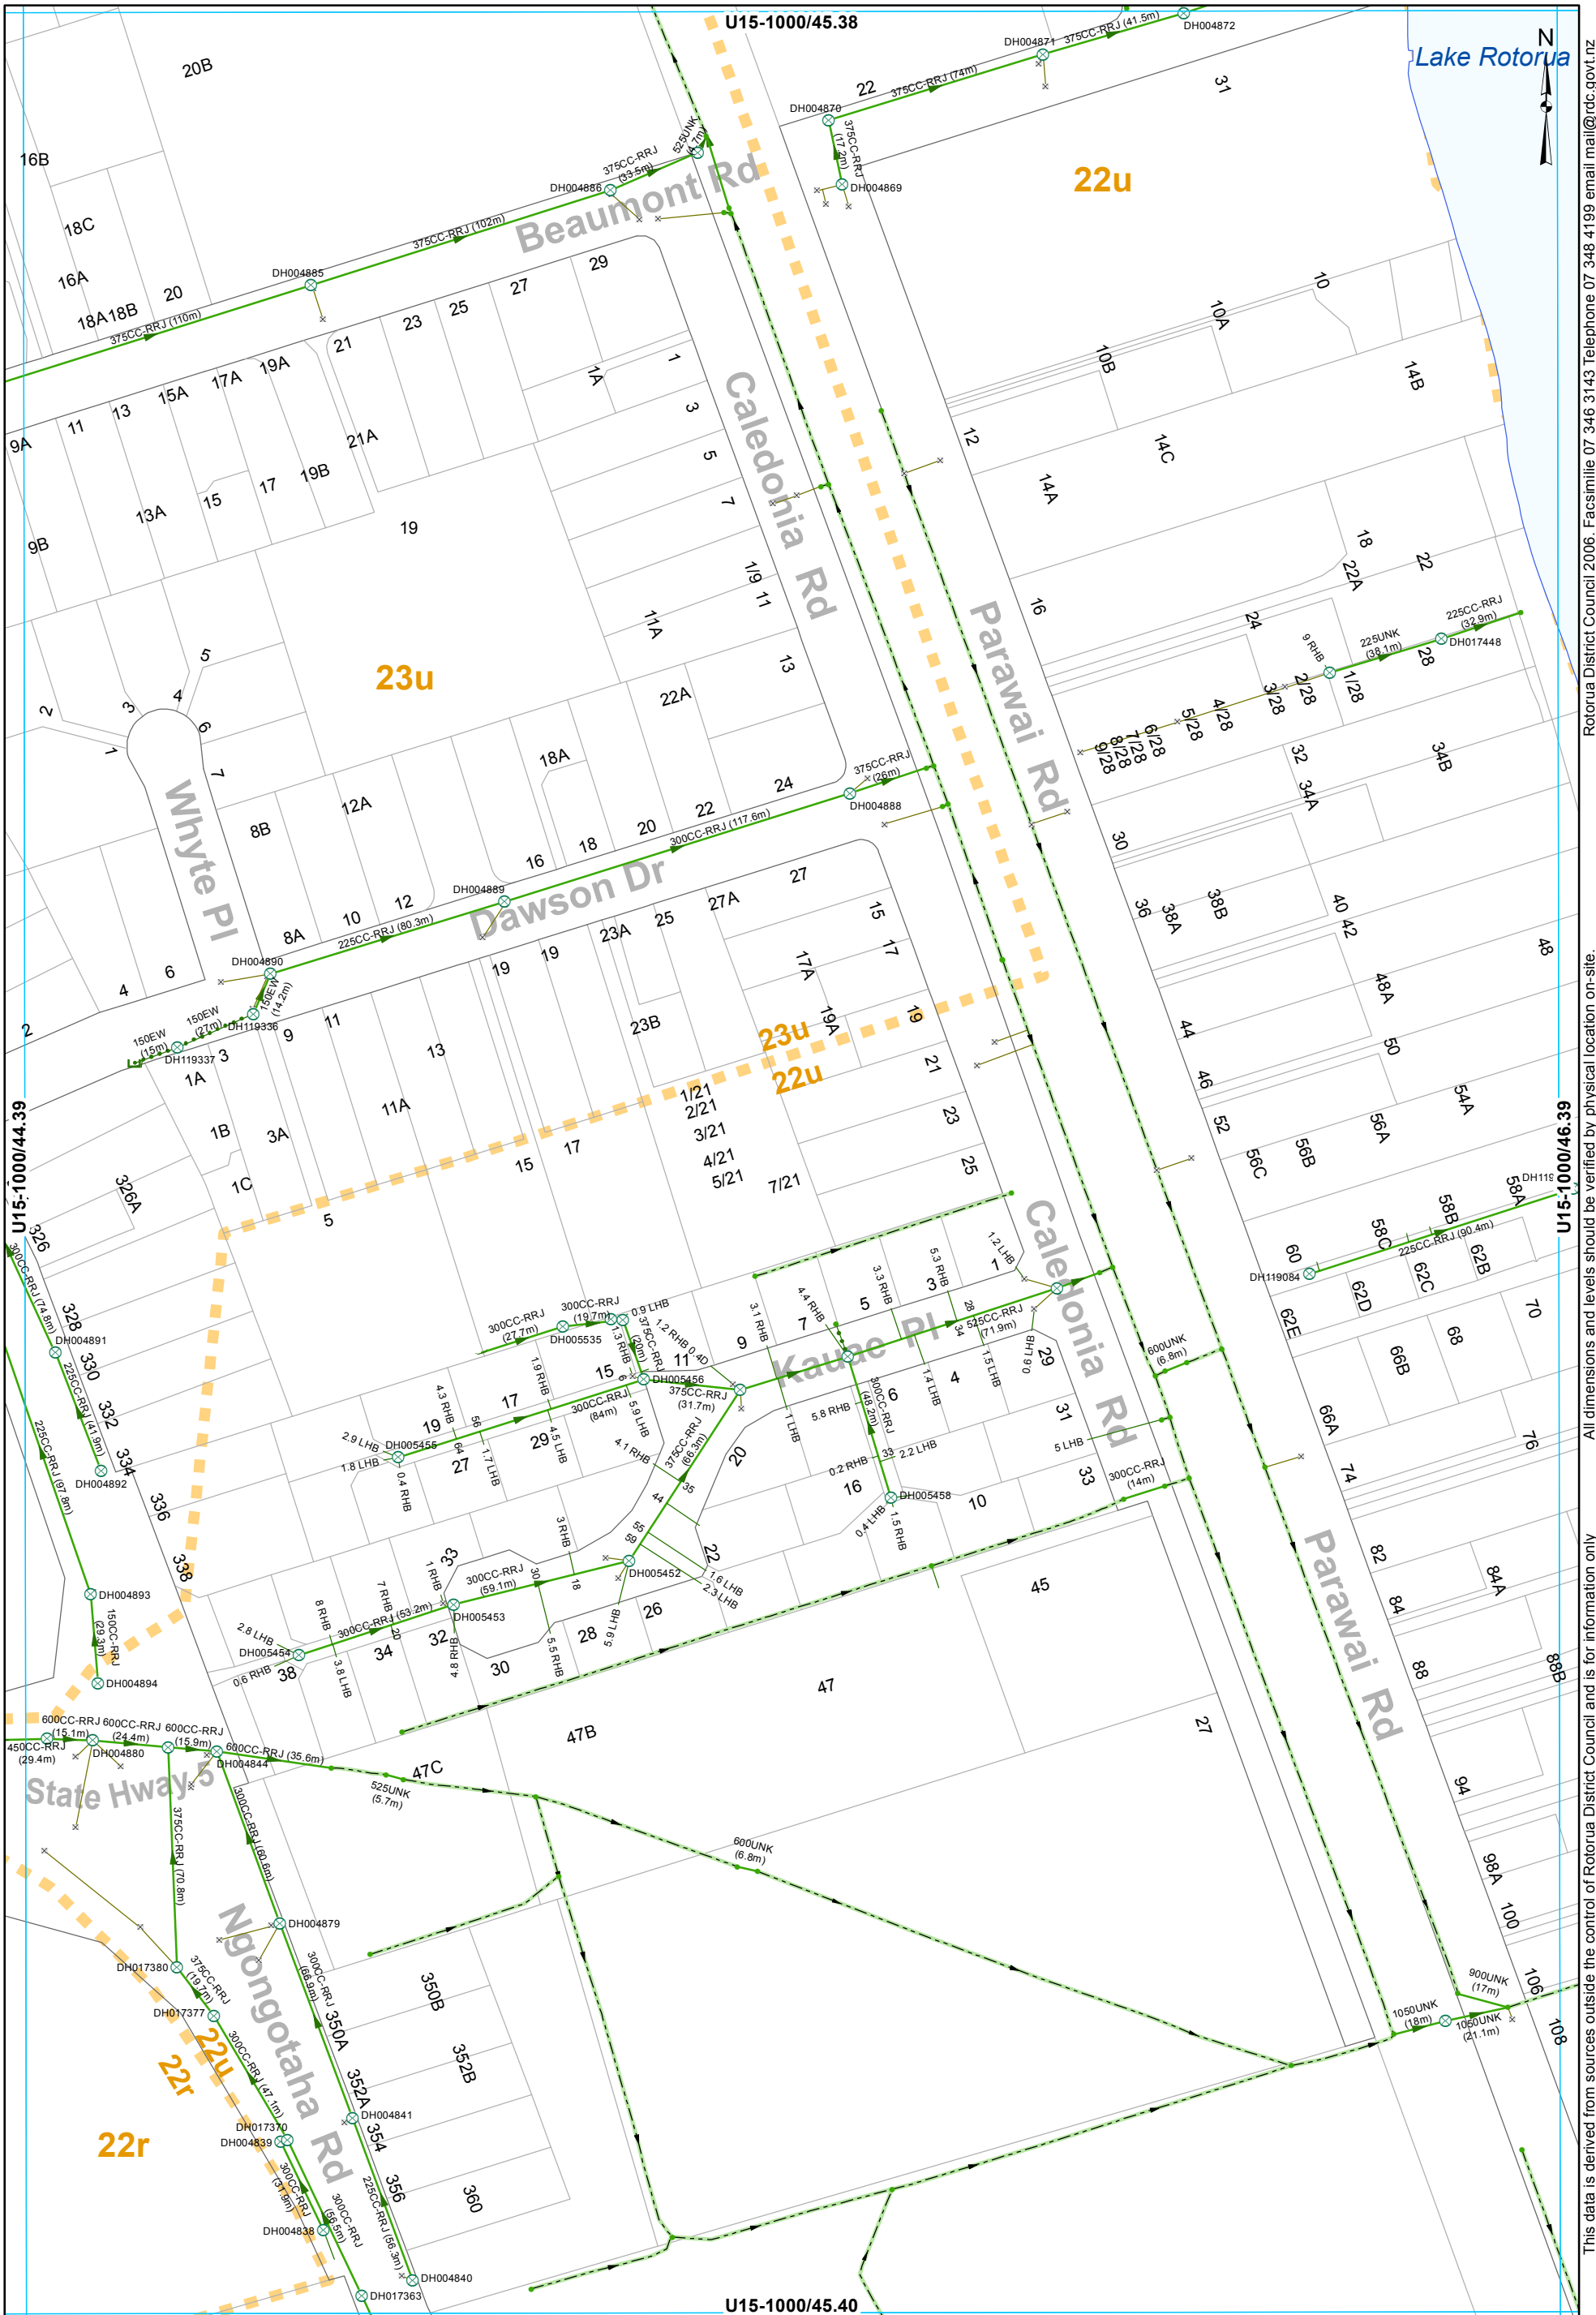

Rotorua District Council 2006. Facsimile 07 346 3143 Telephone 07 348 4199 email mail@rdc.govt.nz

All dimensions and levels outside the control of Rotorua District Council and is for information only

- ⊗ SWManhole
- × SWInlet
- Node
- ⌈ Capped End
- Headwall Structure
- Open Drain
- Culvert
- Gravity Main
- Subsoil Drain
- SWServiceline
- SWServiceline
- SWLead
- Catchment Boundary

**STORMWATER SERVICES**  
1:2000 @ A3 - (U15-1000/45.39)



- ⊗ SWSManhole
- ⊗ SWInlet
- Node
- Open Drain
- Stream
- Gravity Main
- Subsoil Drain
- SWServiceline
- SWServiceline
- SWLead
- Catchment Boundary

**STORMWATER SERVICES**  
**1:2000 @ A3 - (U15-1000/45.38)**


This data is derived from sources outside the control of Rotorua District Council and is for information only

Rotorua District Council 2006. Facsimile 07 346 3143 Telephone 07 348 4199 email mail@rdc.govt.nz

U15-1000/46.37



Lake Rotorua

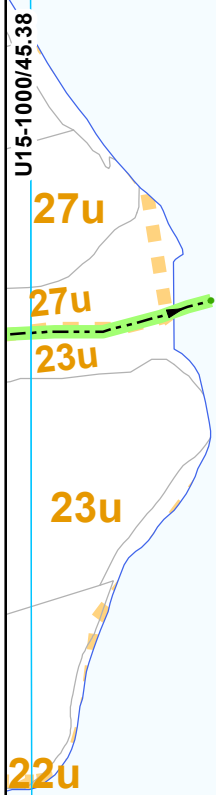

U15-1000/47.38

This data is derived from sources outside the control of Rotorua District Council and is for information only. All dimensions and levels should be verified by physical location on-site.

Rotorua District Council 2006. Facsimile 07 346 3143 Telephone 07 348 4199 email mail@rdc.govt.nz

U15-1000/46.39

- Node
- Stream
- Catchment Boundary





All dimensions and levels should be verified by physical location on-site. Rotorua District Council 2006. Facsimile 07 346 3143 Telephone 07 348 4199 email mail@rdc.govt.nz

- ⊗ SWManhole
- × SWInlet
- Node
- Open Drain
- Stream
- Gravity Main
- Subsoil Drain
- SWServiceline
- SWServiceline
- SWLead
- Catchment Boundary

**STORMWATER SERVICES**  
1:2000 @ A3 - (U15-1000/45.38)