


Storm Water Asbuilt Sheet Index
 SWCatchment 28u


Compiled on 2021-06-15 from as-builts of various dates. For up to date as-builts please visit http://geo.rdc.govt.nz/images/plotfiles/3waters_mobile_asbuilts/

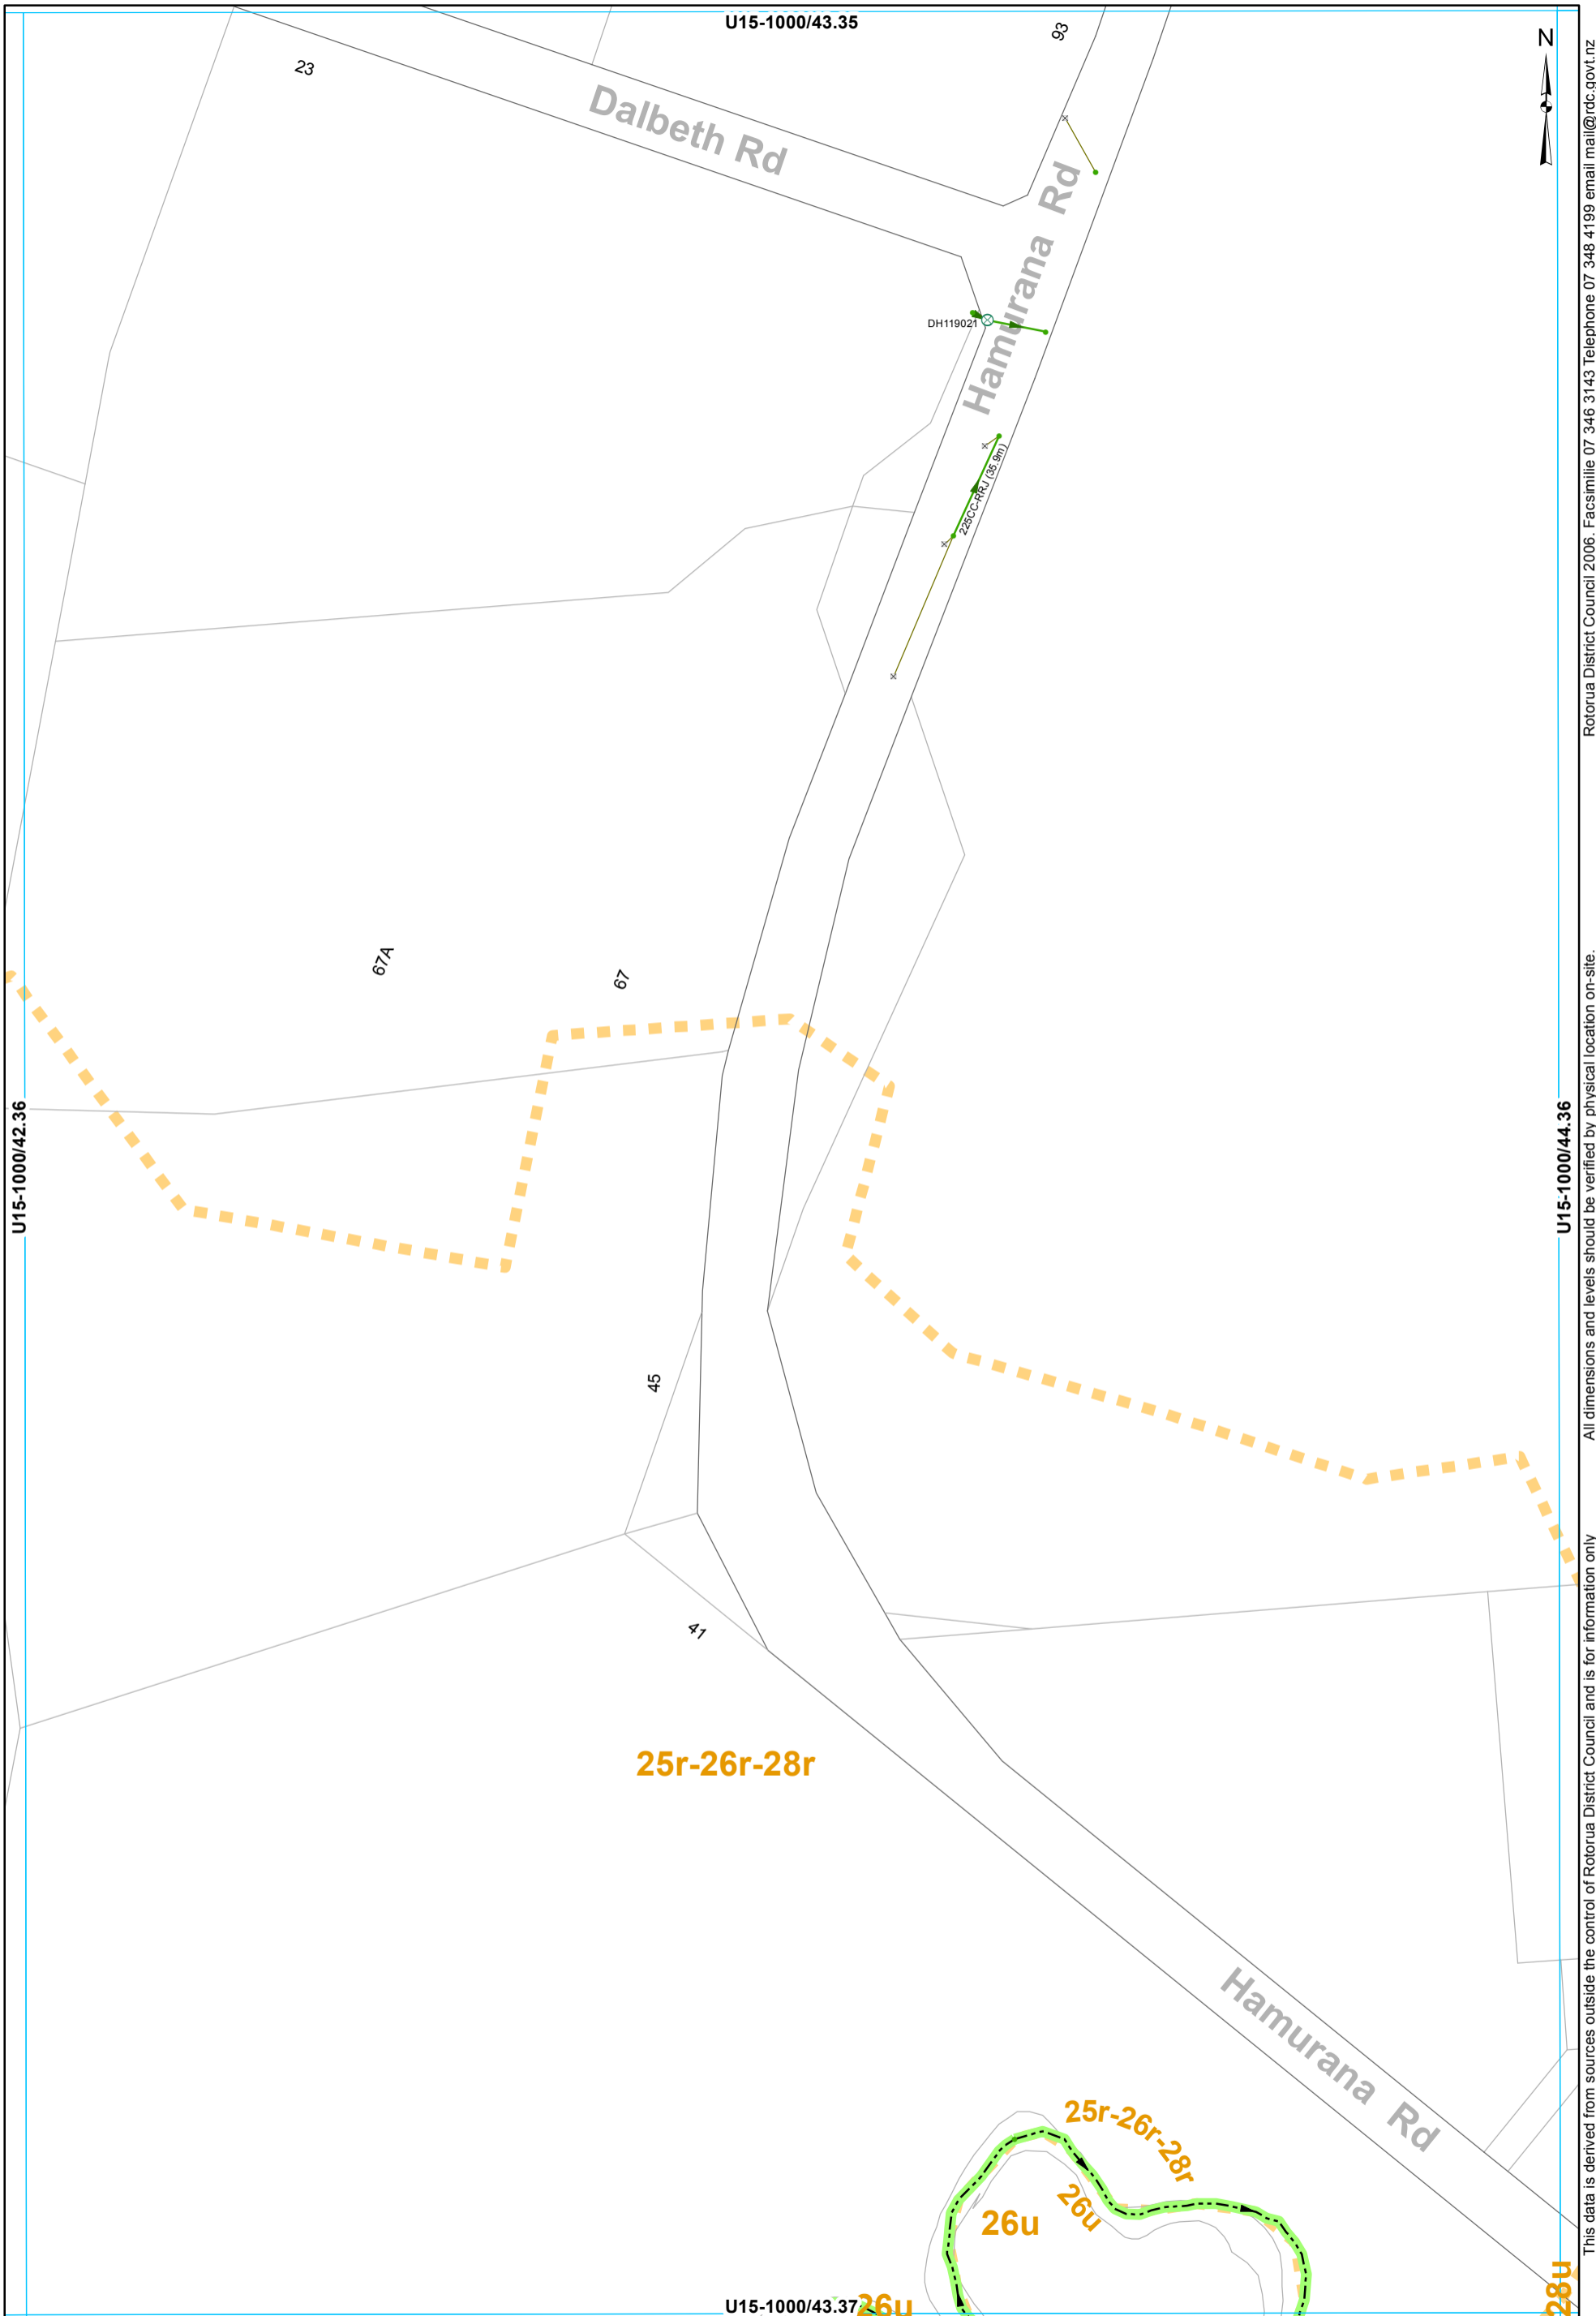

- ⊗ SWManhole
- × SWInlet
- Node
- Stream
- Gravity Main
- SWLead
- Catchment Boundary

STORMWATER SERVICES
1:2000 @ A3 - (U15-1000/43.36)

All dimensions and levels should be verified by physical location on-site. Rotorua District Council 2006. Facsimile 07 346 3143 Telephone 07 348 4199 email mail@rdc.govt.nz

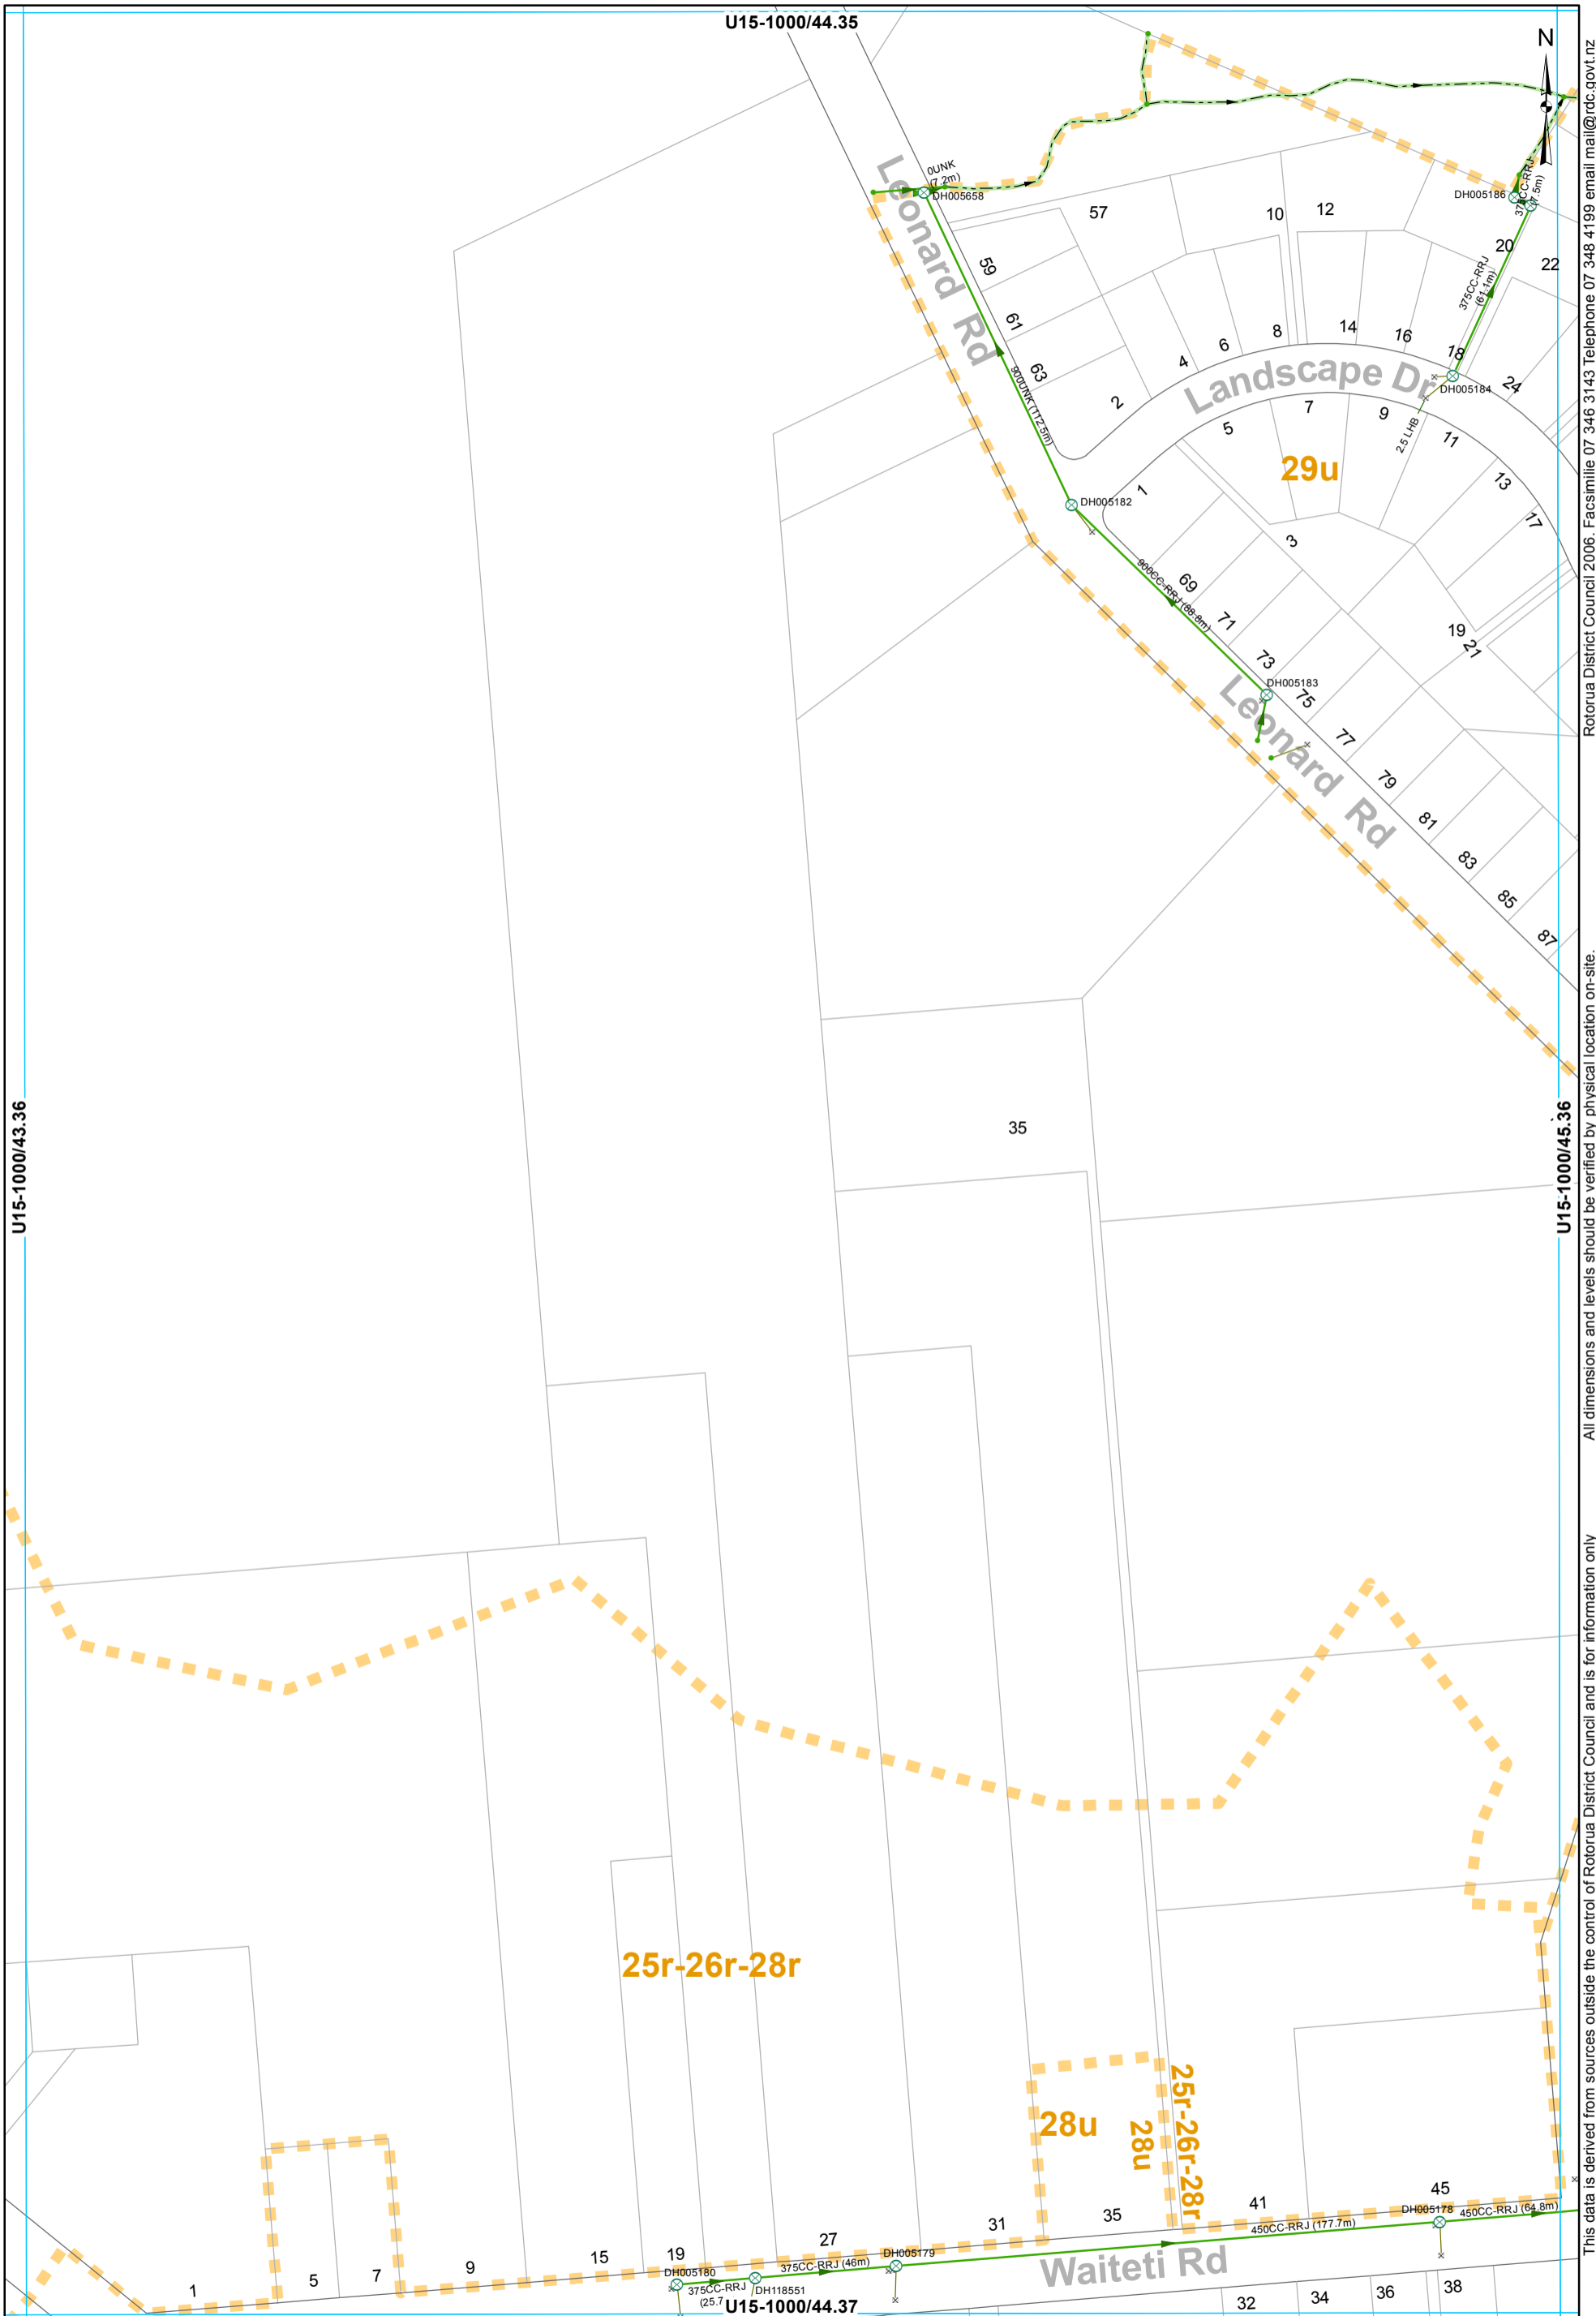

U15-1000/43.36

U15-1000/45.36

U15-1000/44.35


U15-1000/44.37

- ⊗ SWManhole
- × SWInlet
- Node
- Open Drain
- Gravity Main
- SWServiceline
- SWServiceline
- SWLead
- Catchment Boundary

STORMWATER SERVICES
1:2000 @ A3 - (U15-1000/44.36)


All dimensions and levels should be verified by physical location on-site. Rotorua District Council 2006. Facsimile 07 346 3143 Telephone 07 348 4199 email mail@rdc.govt.nz

This data is derived from sources outside the control of Rotorua District Council and is for information only

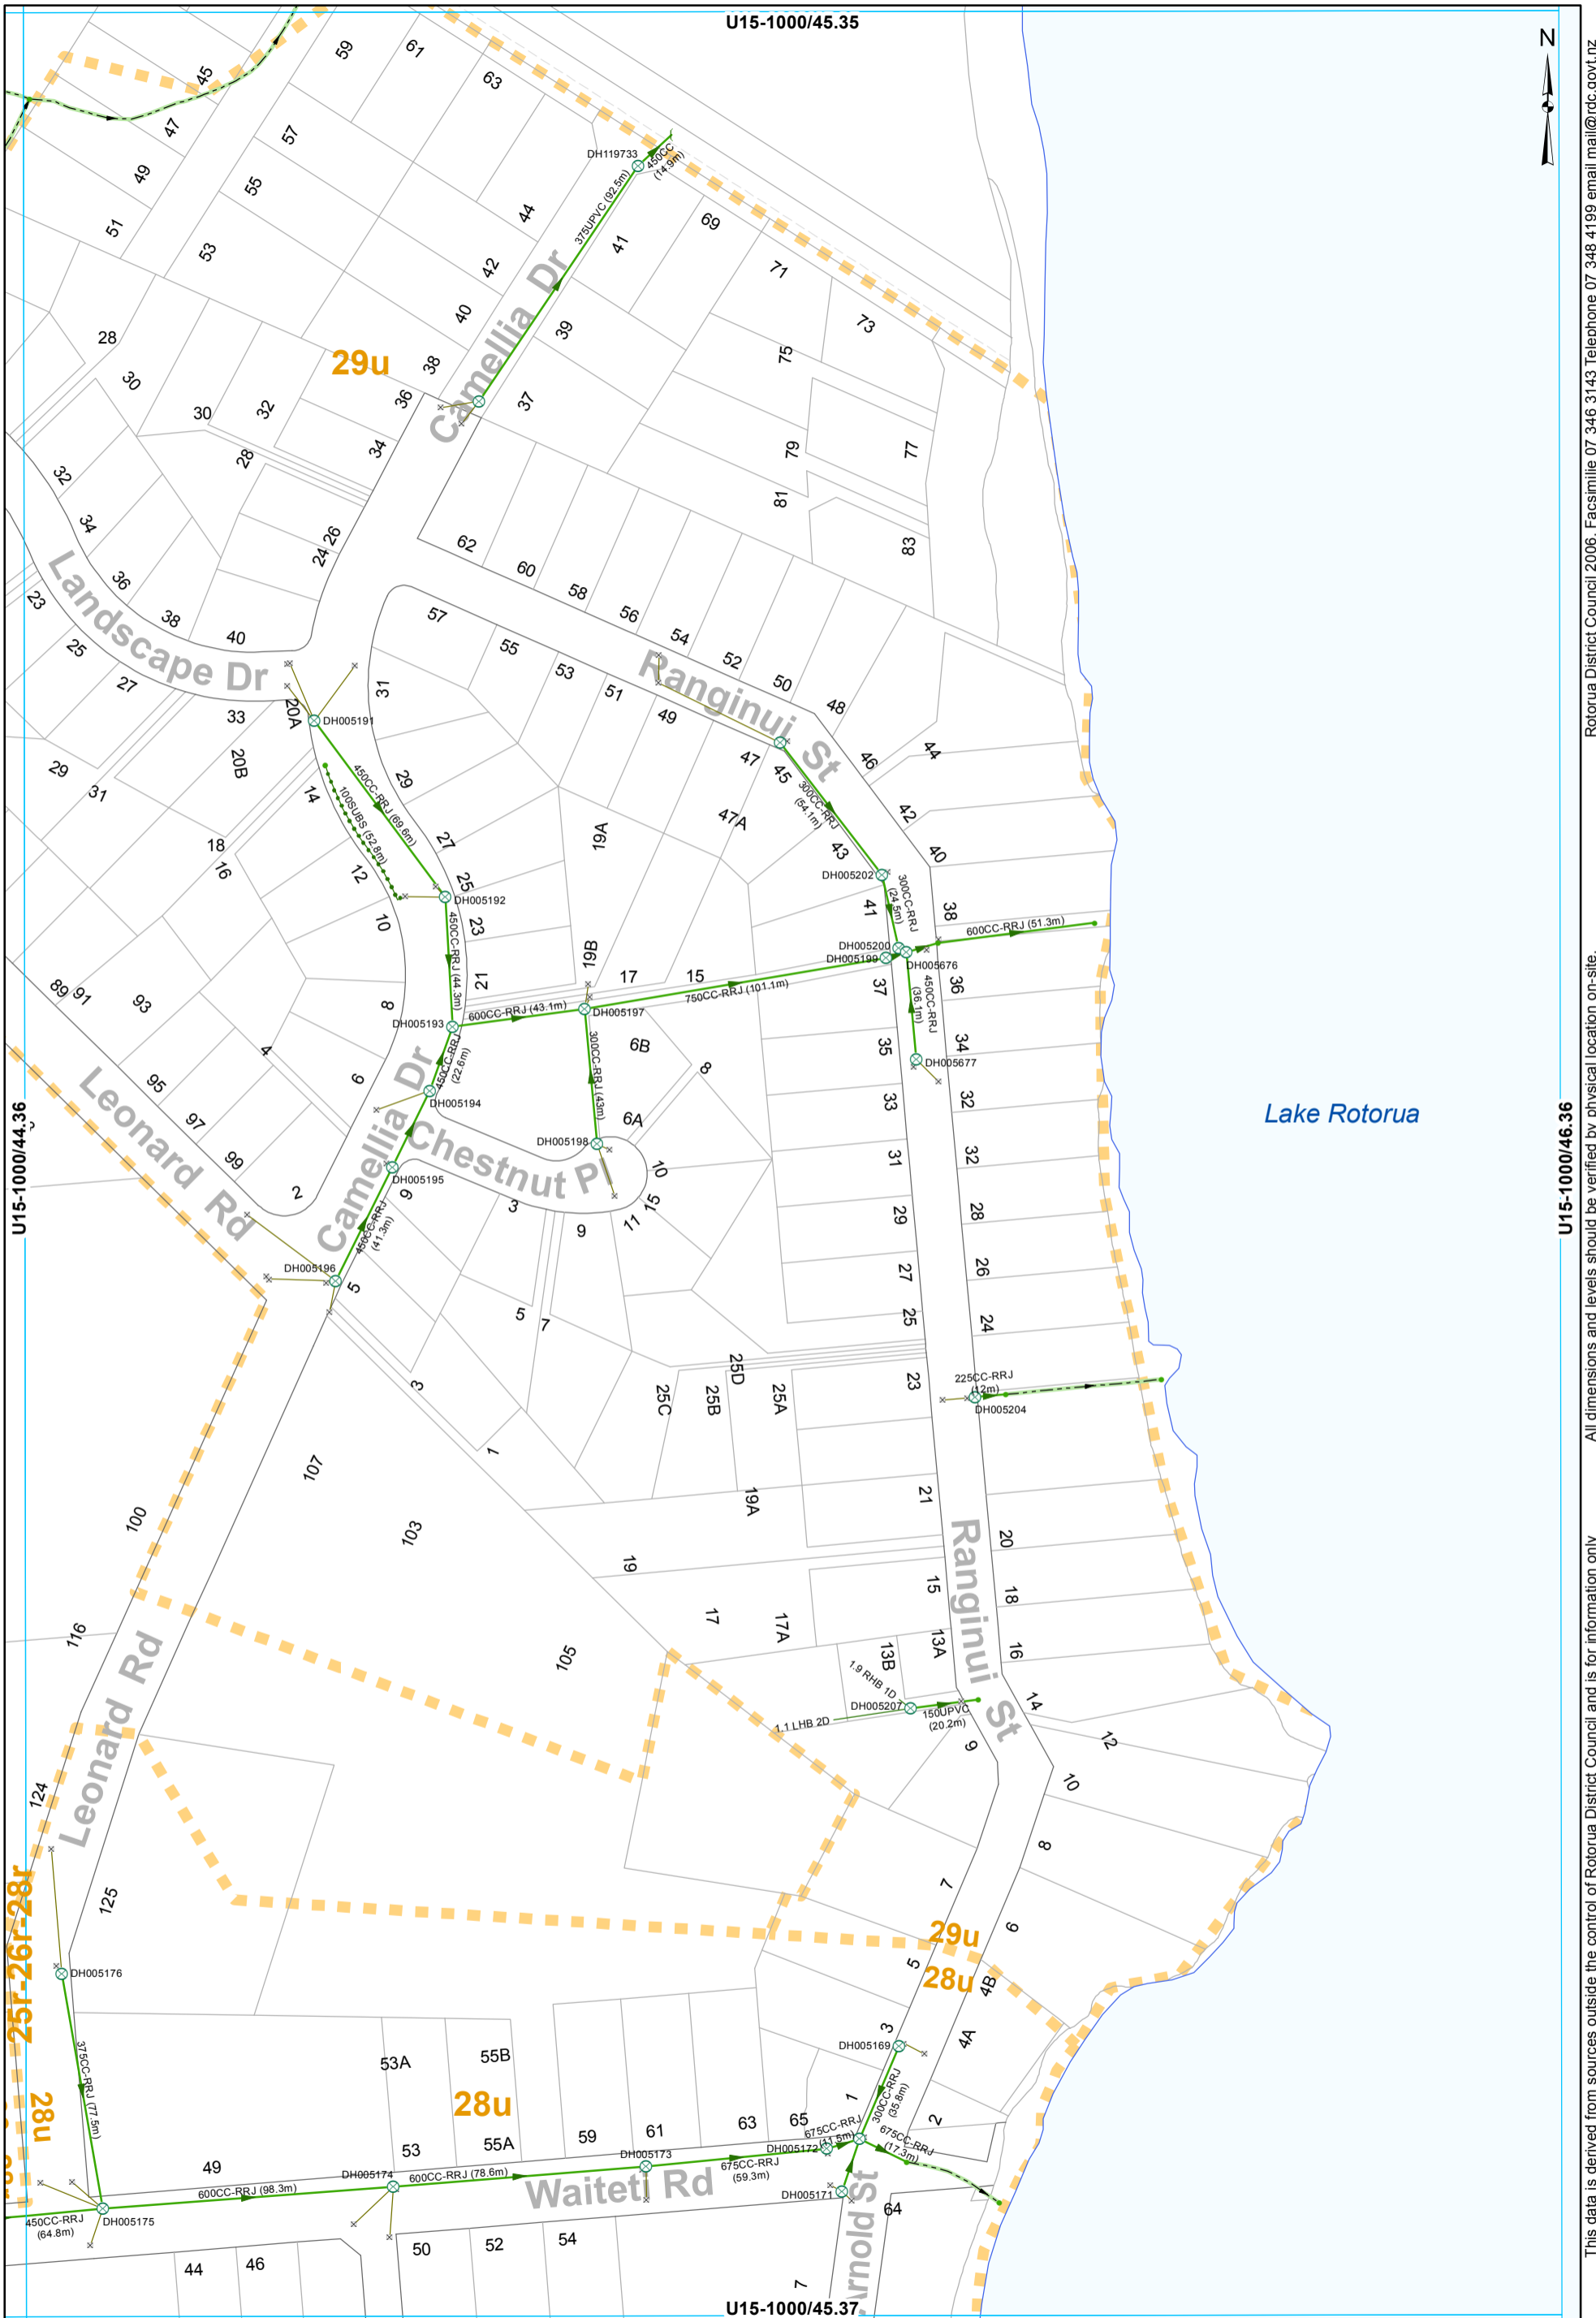

- ⊗ SWManhole
- × SWInlet
- Node
- Headwall Structure
- Open Drain
- Subsoil Drain
- Gravity Main
- SWServiceline
- SWServiceline
- SWLead
- Catchment Boundary

STORMWATER SERVICES
1:2000 @ A3 - (U15-1000/45.36)

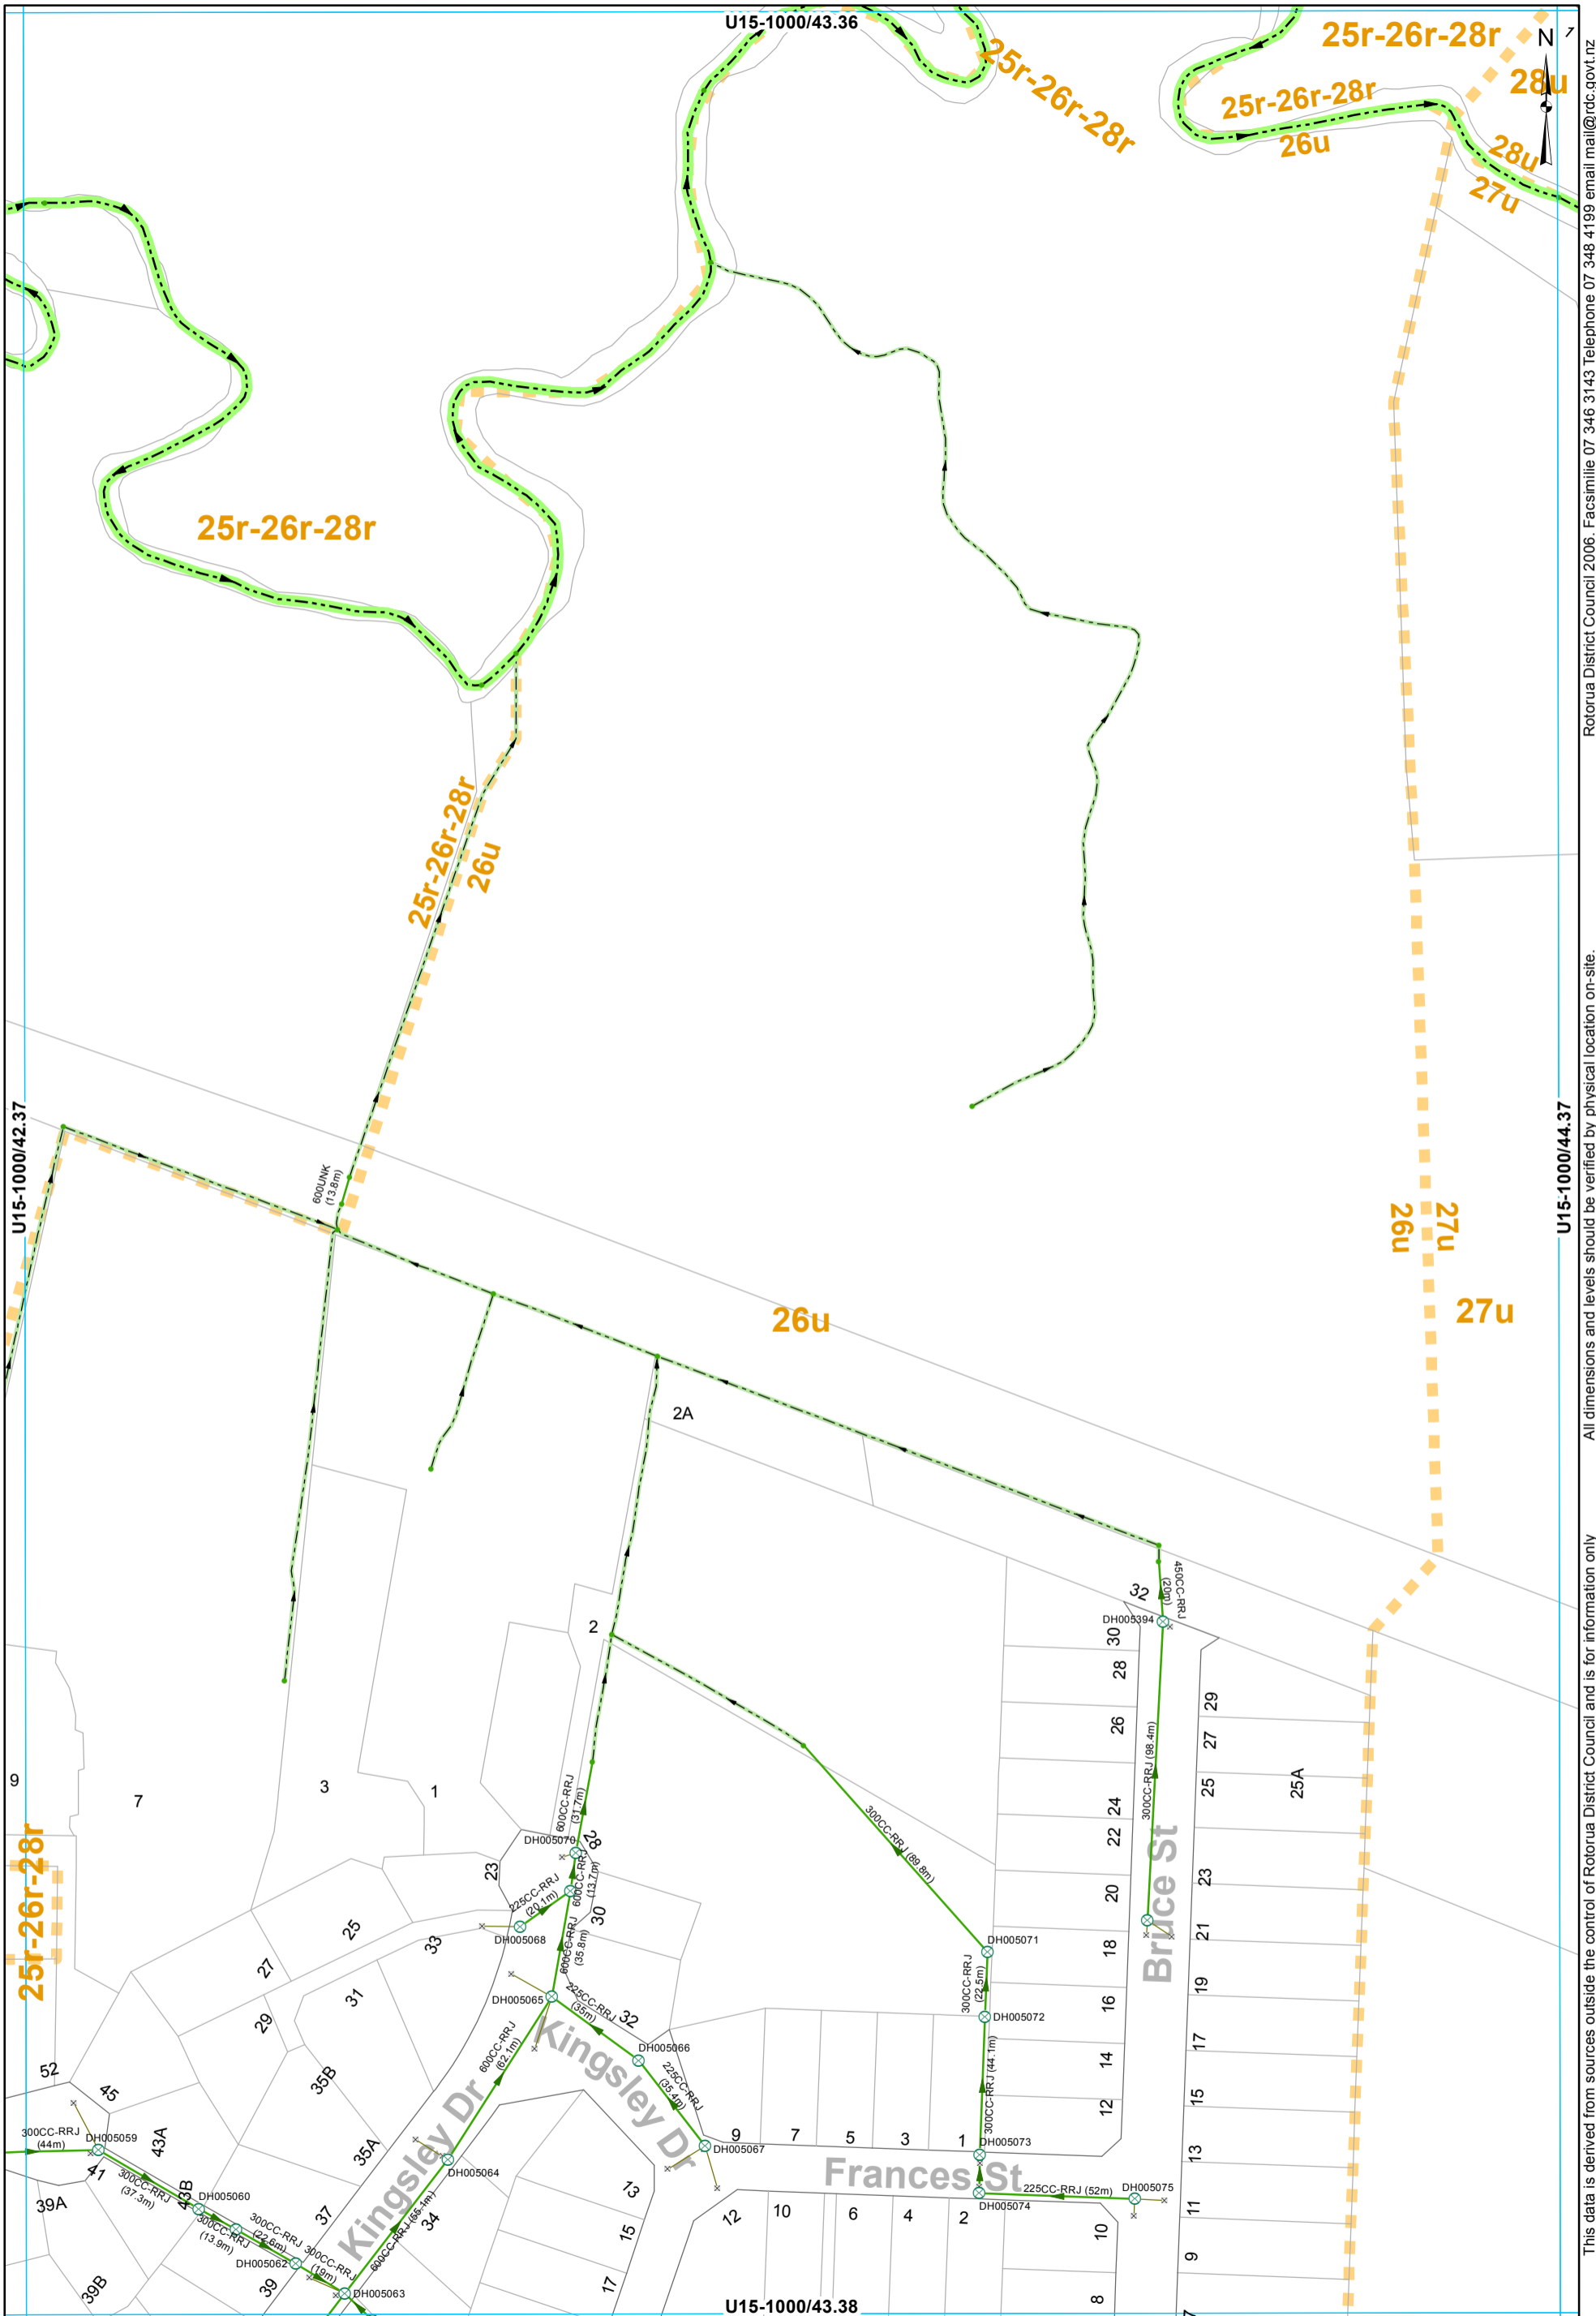

- ⊗ SWManhole
- × SWInlet
- Node
- Open Drain
- Stream
- Culvert
- Gravity Main
- SWLead
- Catchment Boundary

STORMWATER SERVICES
1:2000 @ A3 - (U15-1000/43.37)

This data is derived from sources outside the control of Rotorua District Council and is for information only

All dimensions and levels should be verified by physical location on-site.

Rotorua District Council 2006. Facsimile 07 346 3143 Telephone 07 348 4199 email mail@rdc.govt.nz




- ⊗ SWManhole
- × SWInlet
- Node
- Stream
- Gravity Main
- Subsoil Drain
- SWServiceline
- SWServiceline
- SWLead
- Catchment Boundary

STORMWATER SERVICES
1:2000 @ A3 - (U15-1000/44.37)

This data is derived from sources outside the control of Rotorua District Council and is for information only

All dimensions and levels should be verified by physical location on-site.

Rotorua District Council 2006. Facsimile 07 346 3143 Telephone 07 348 4199 email mail@rdc.govt.nz

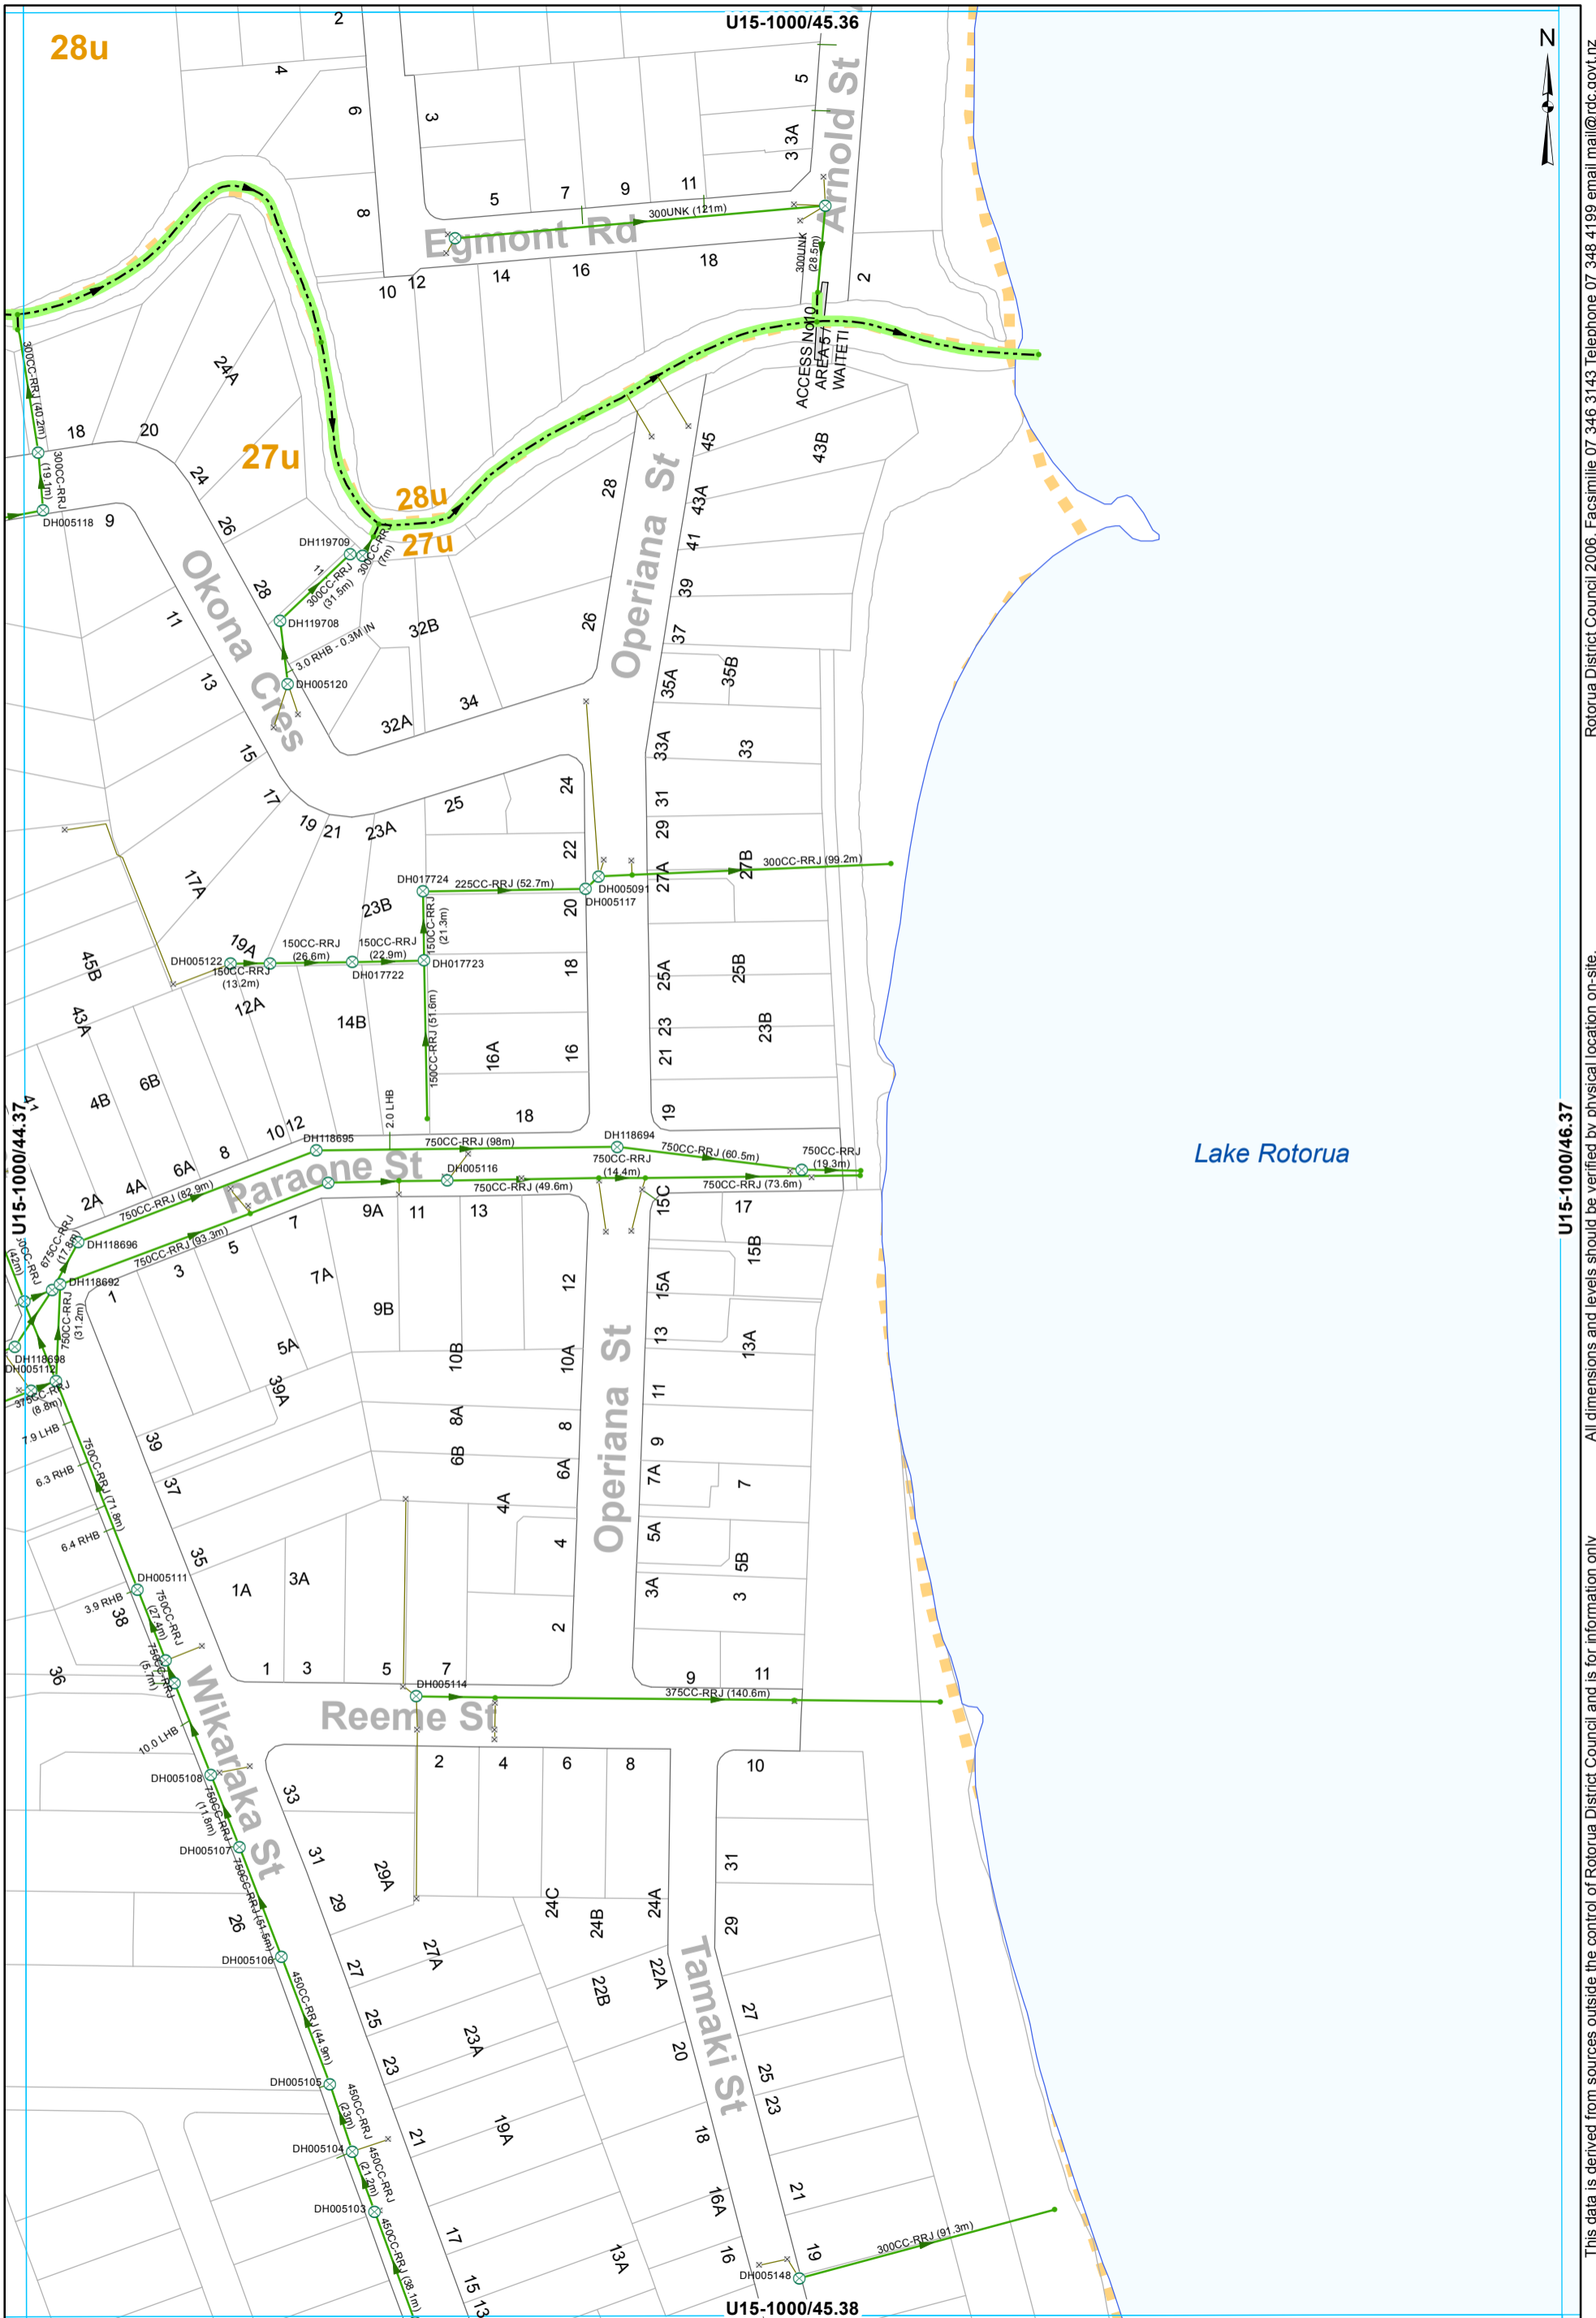

- ⊗ SWManhole
- × SWInlet
- Node
- Stream
- Gravity Main
- SWServiceline
- SWServiceline
- SWLead
- Catchment Boundary

STORMWATER SERVICES
1:2000 @ A3 - (U15-1000/45.37)

U15-1000/45.36
 U15-1000/44.37
 U15-1000/46.37
 U15-1000/45.38
 Rotorua District Council 2006. Facsimile 07 346 3143 Telephone 07 348 4199 email mail@rdc.govt.nz
 All dimensions and levels should be verified by physical location on-site.
 This data is derived from sources outside the control of Rotorua District Council and is for information only