




Storm Water Asbuilt Sheet Index
SWcatchment 5r

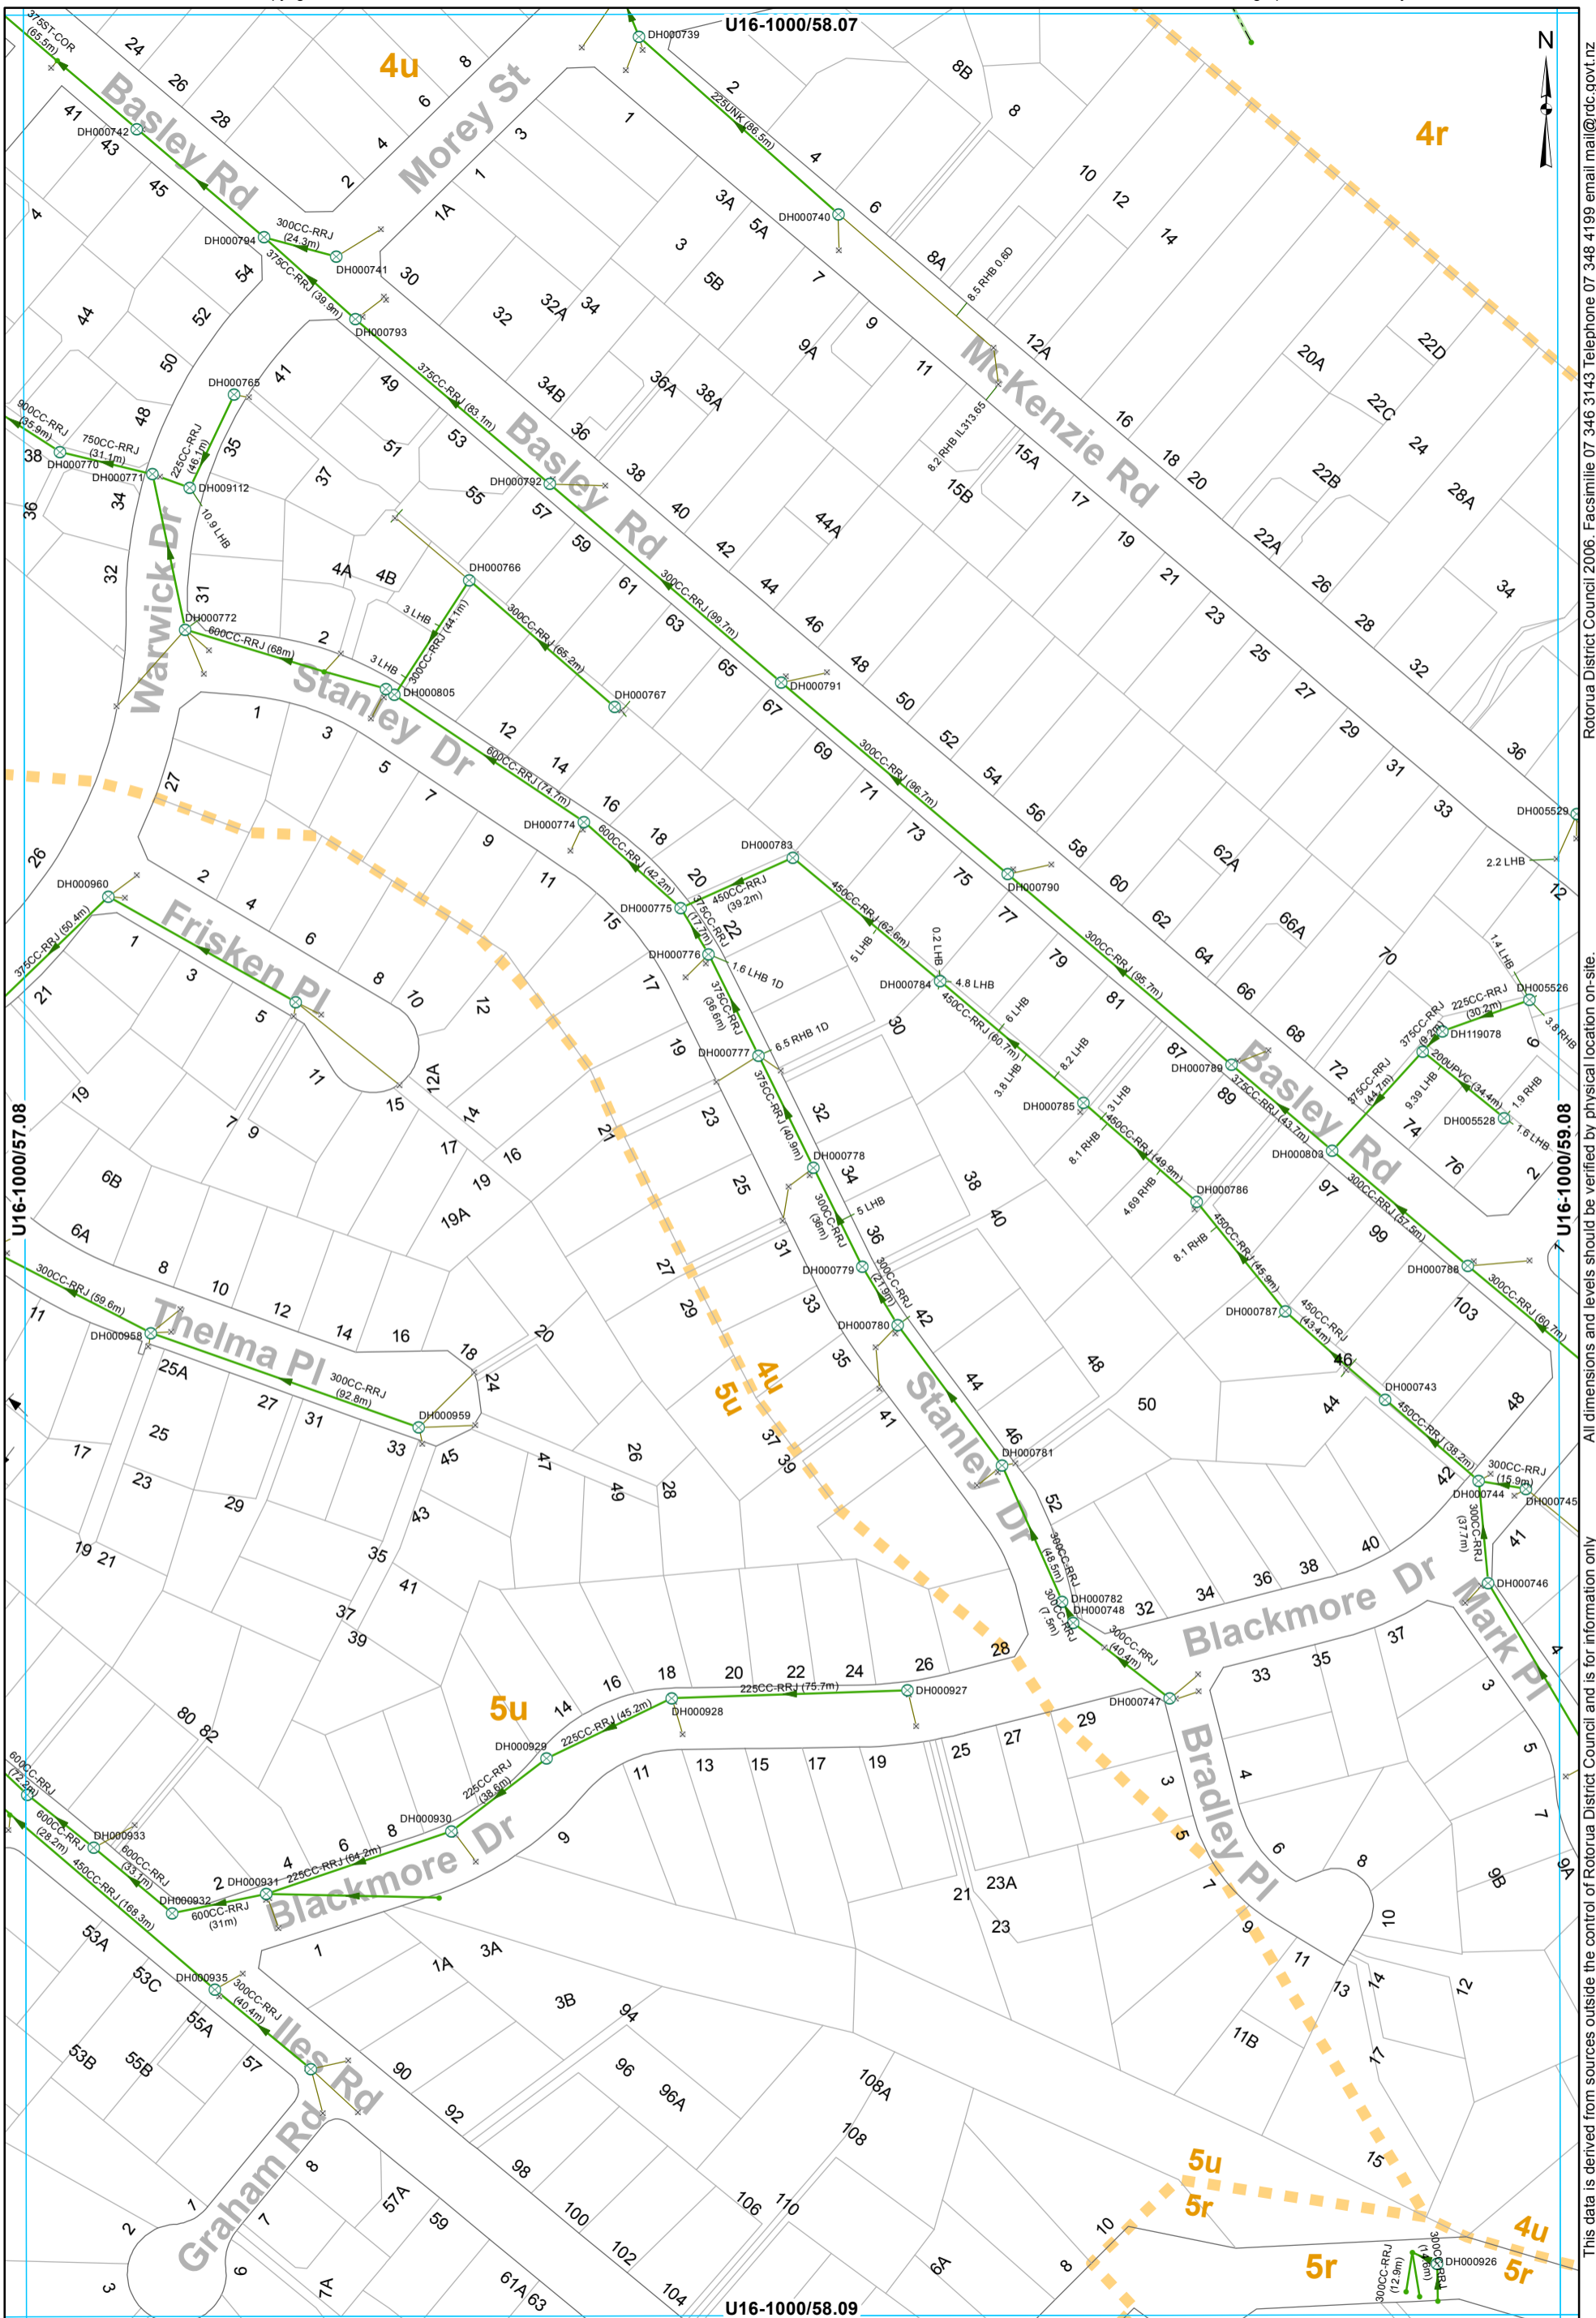


- ⊗ SWManhole
- × SWInlet
- Node
- Open Drain
- Gravity Main
- SWServiceLine
- SWServiceLine
- SWLead
- Catchment Boundary

STORMWATER SERVICES
1:2000 @ A3 - (U16-1000/58.08)

All dimensions and levels should be verified by physical location on-site. This data is derived from sources outside the control of Rotorua District Council and is for information only.

Rotorua District Council 2006. Facsimile 07 346 3143 Telephone 07 348 4199 email mail@rdc.govt.nz


U16-1000/59.07

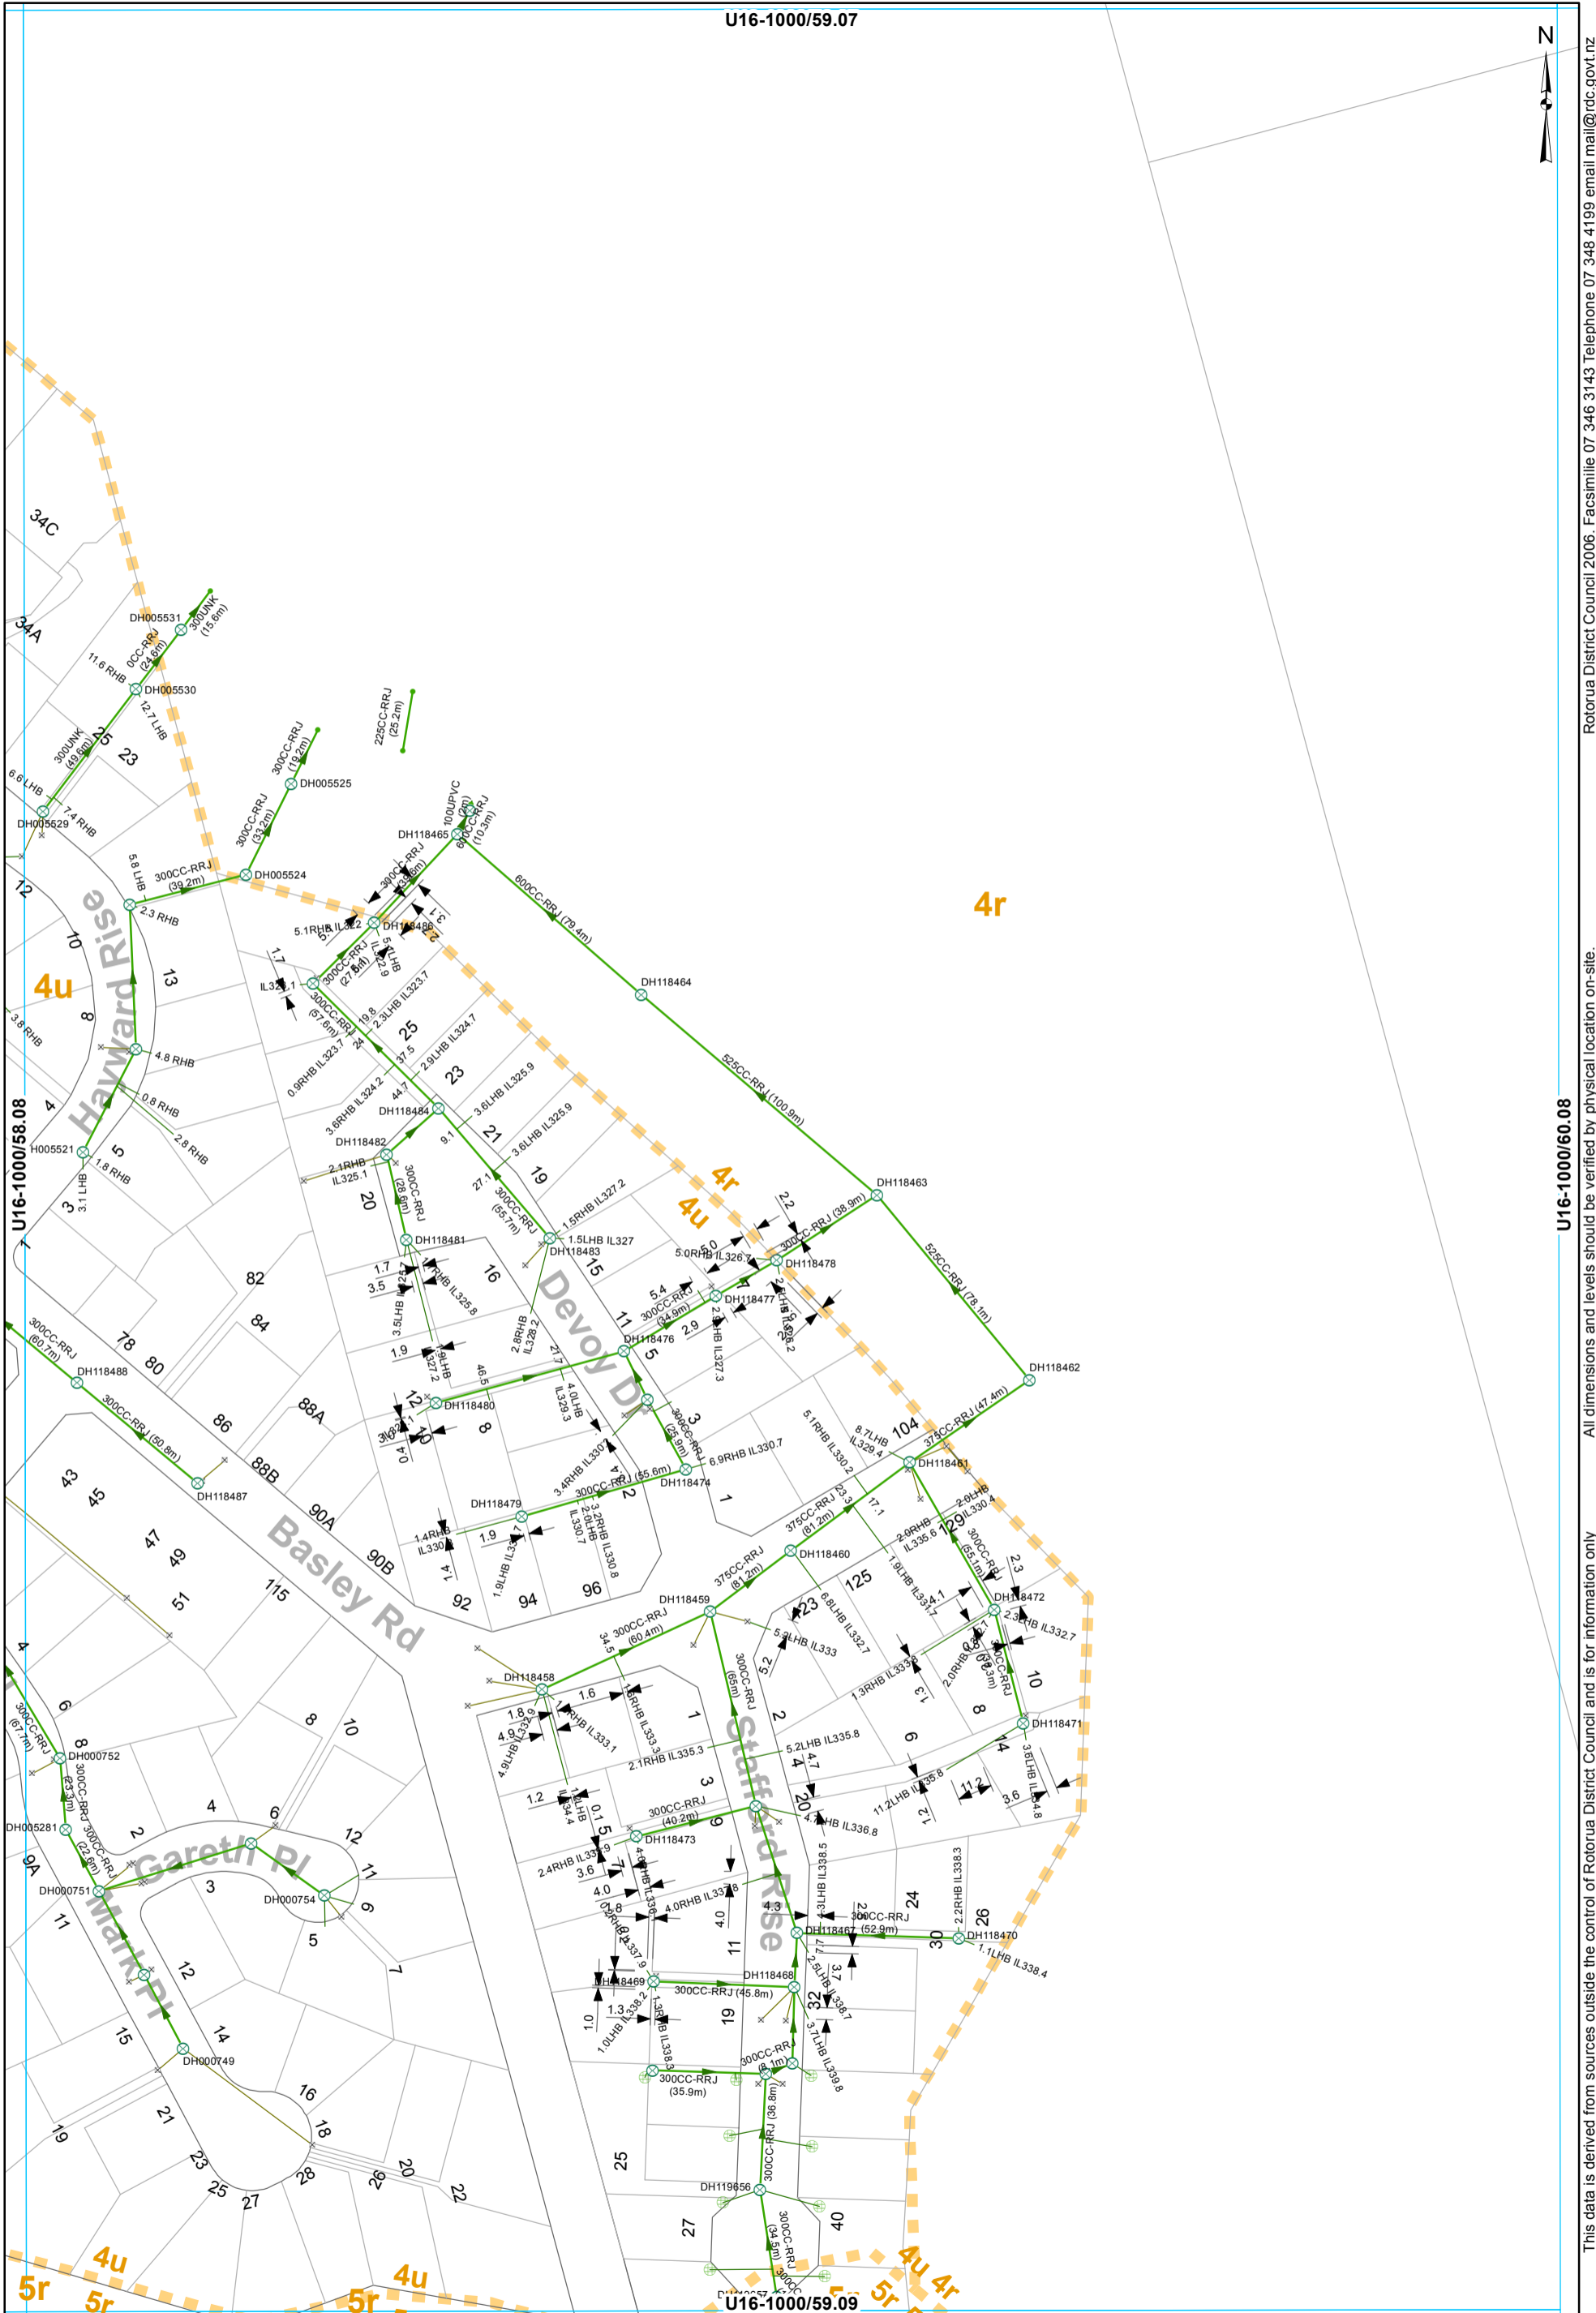

U16-1000/60.08

This data is derived from sources outside the control of Rotorua District Council and is for information only. All dimensions and levels should be verified by physical location on-site.


Rotorua District Council 2006. Facsimile 07 346 3143 Telephone 07 348 4199 email mail@rdc.govt.nz

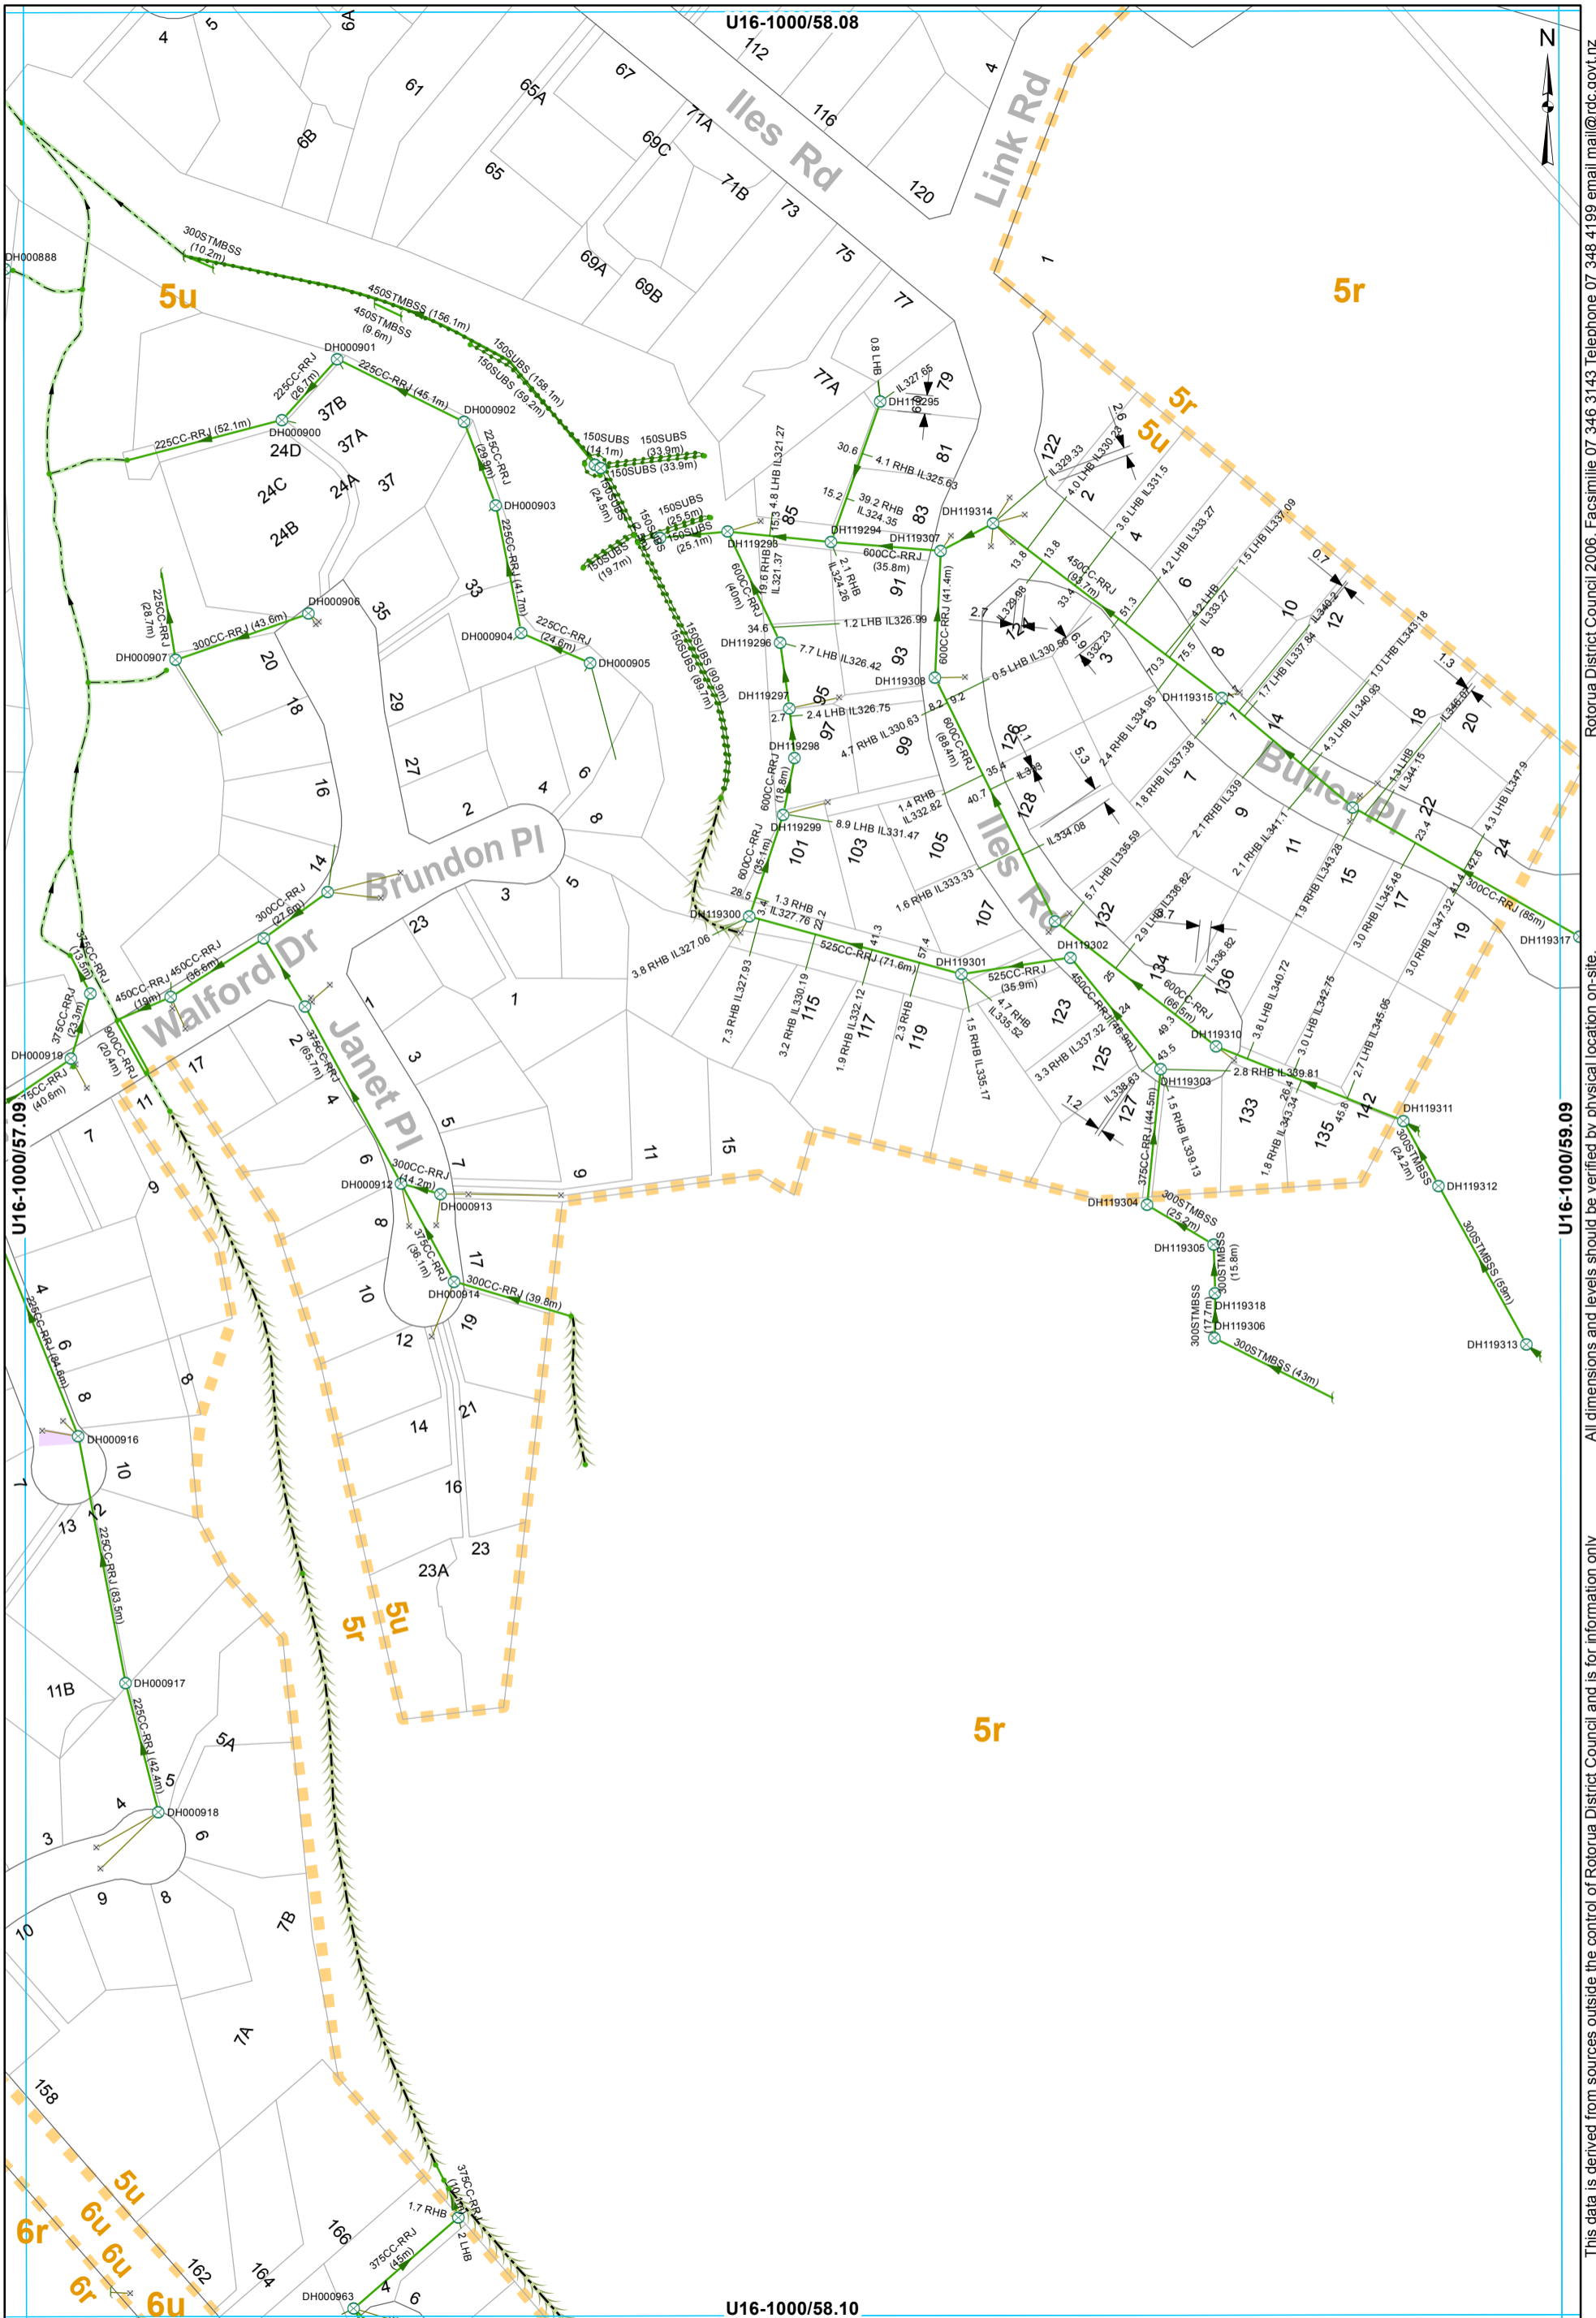

- ⊗ SWManhole
- × SWInlet
- Node
- Headwall Structure
- Open Drain
- Overland Flow
- Culvert
- Gravity Main
- Subsoil Drain
- SWServiceline
- SWServiceline
- SWLead
- Catchment Boundary

STORMWATER SERVICES
1:2000 @ A3 - (U16-1000/58.09)

Rotorua District Council 2006. Facsimile 07 346 3143 Telephone 07 348 4199 email mail@rdc.govt.nz
 All dimensions and levels should be verified by physical location on-site.
 This data is derived from sources outside the control of Rotorua District Council and is for information only

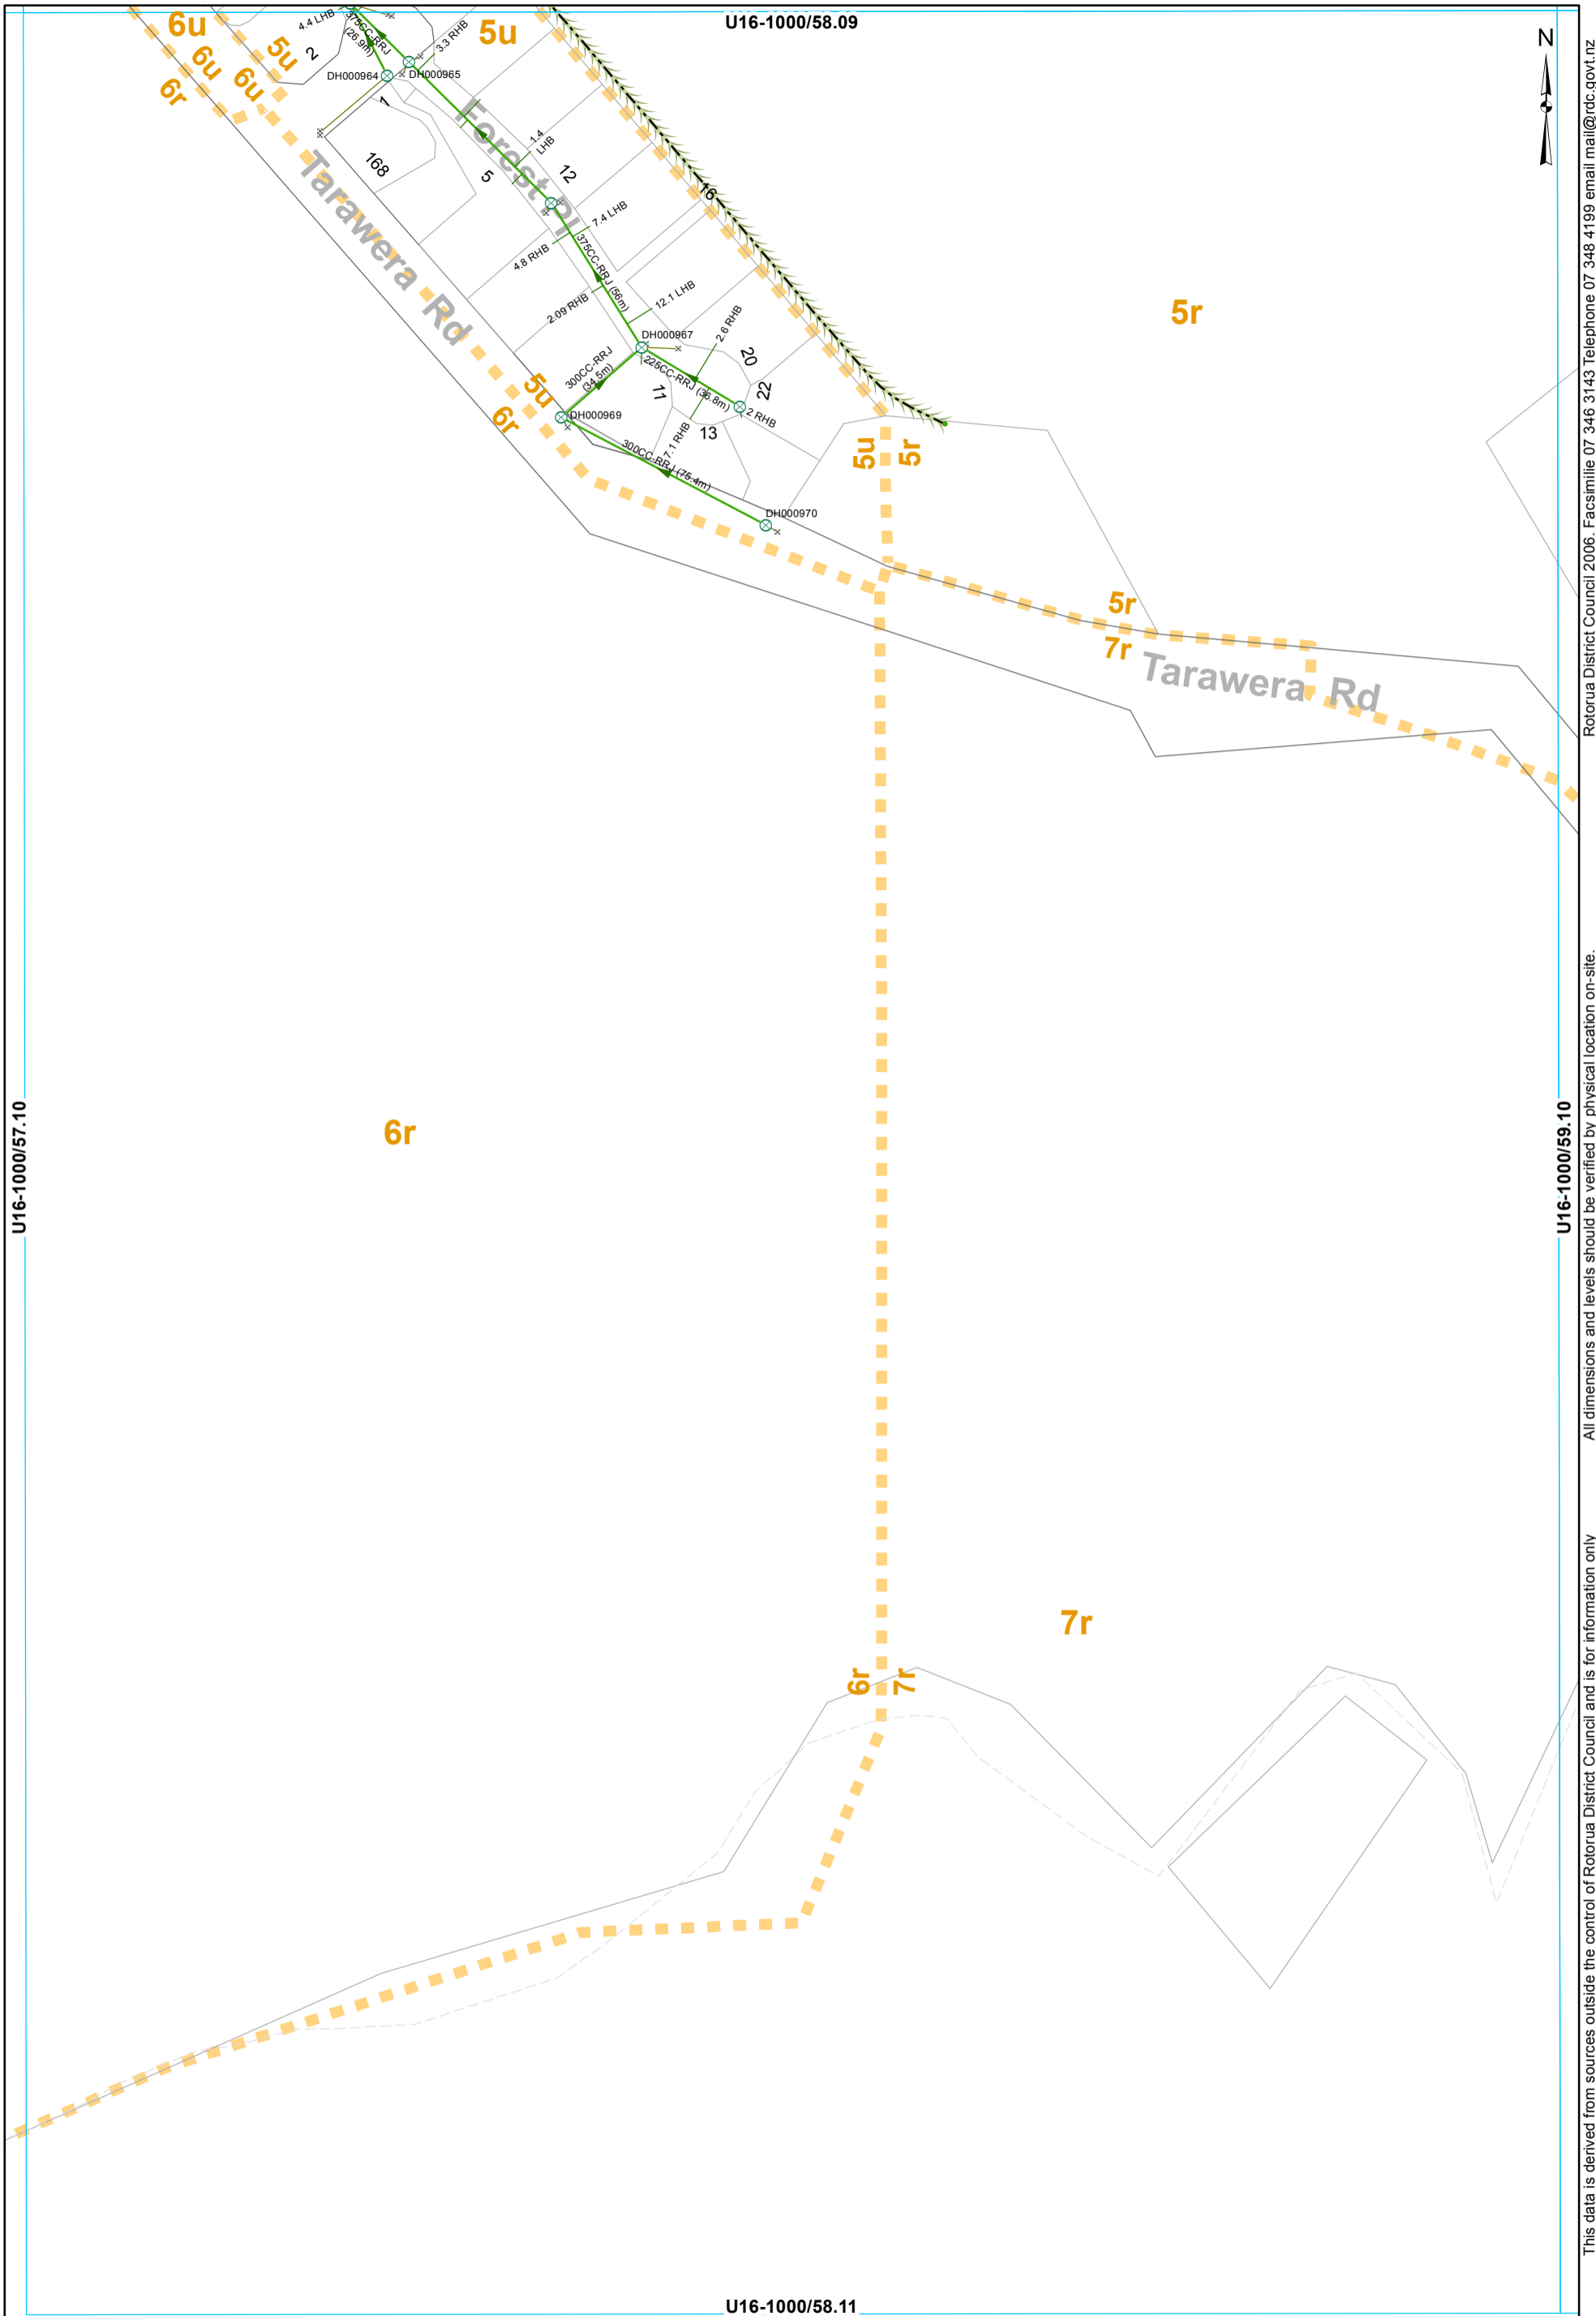

U16-1000/57.10

U16-1000/59.10


U16-1000/58.09

U16-1000/58.11

- ⊗ SWManhole
- × SWInlet
- Node
- Overland Flow
- Gravity Main
- SWServiceline
- SWLead
- Catchment Boundary

STORMWATER SERVICES
 1:2000 @ A3 - (U16-1000/58.10)

Rotorua District Council 2006. Facsimile 07 346 3143 Telephone 07 348 4199 email mail@rdc.govt.nz
 All dimensions and levels should be verified by physical location on-site.
 This data is derived from sources outside the control of Rotorua District Council and is for information only

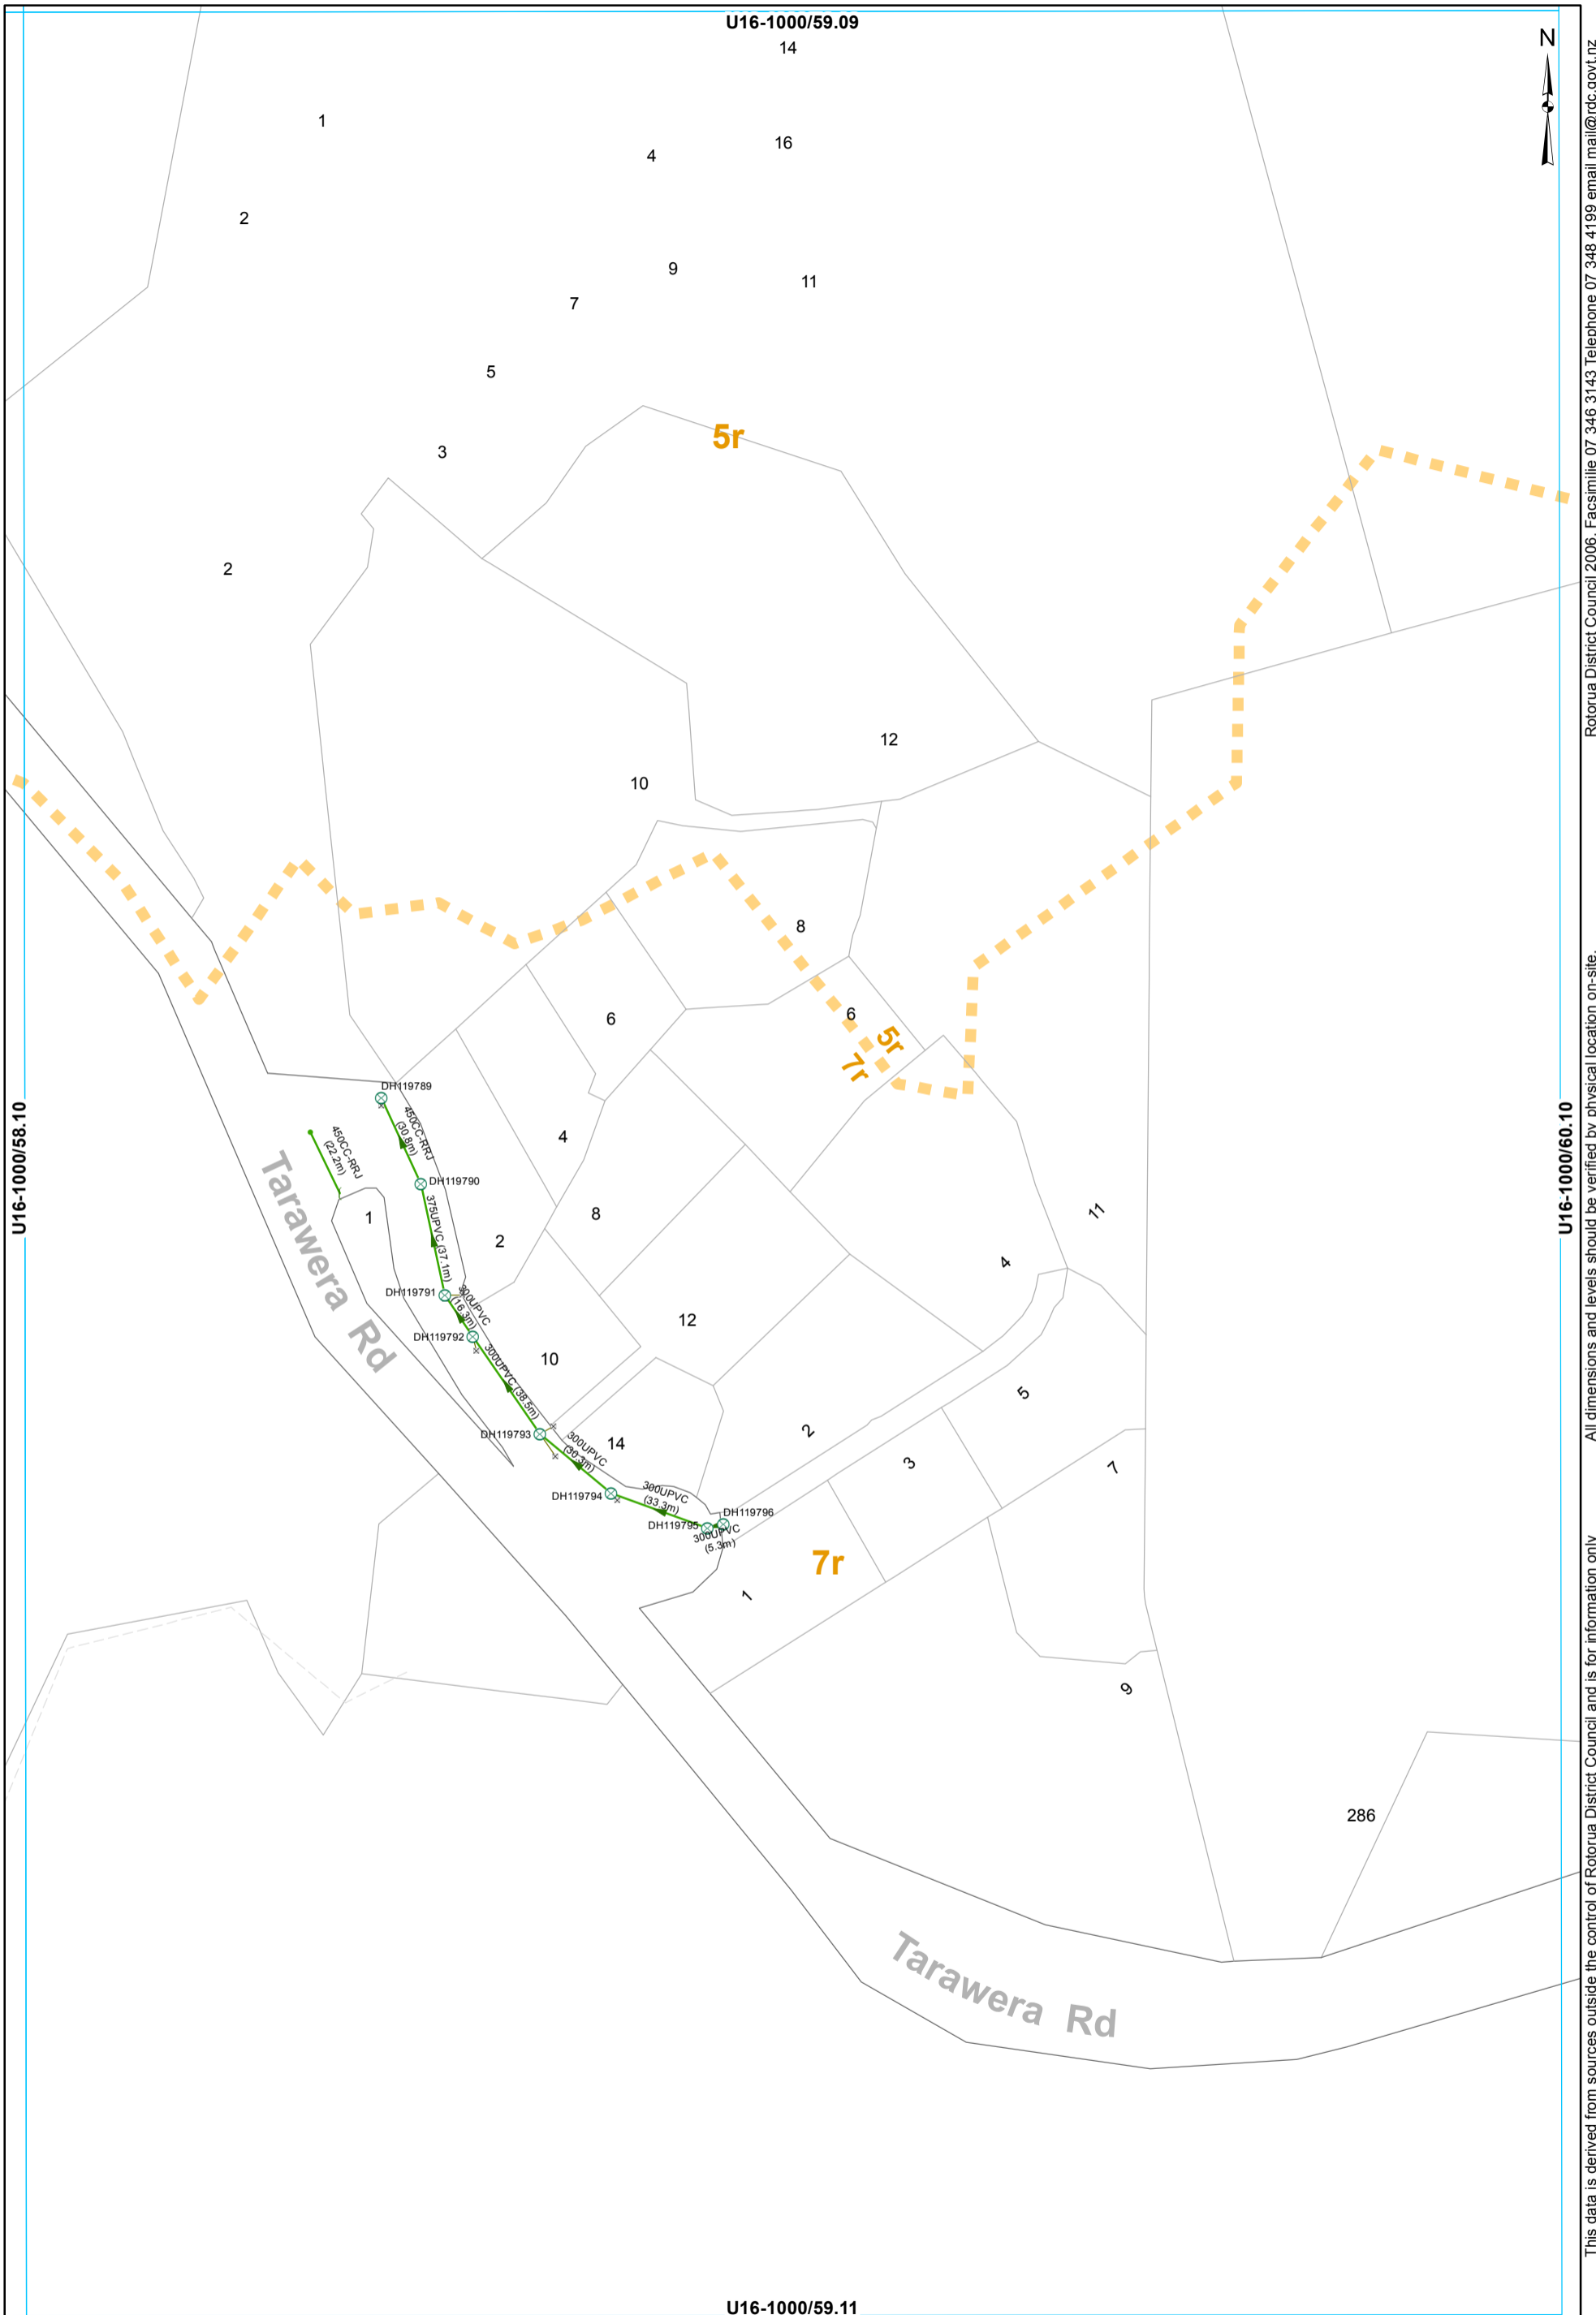

U16-1000/59.09

14

1

4

16

2

9

11

7

5

5r

3

12

10

8

6

5t

Tarawera Rd

1

2

4

8

12

10

14

2

3

5

1

DH119793

300UPVC (29.3m)

DH119794

300UPVC (33.3m)

DH119795

300UPVC (5.3m)

DH119796

300UPVC (5.3m)

DH119789

450CC-RRJ (2.2m)

DH119790

450CC-RRJ (0.8m)

DH119791

375UPVC (1.7m)

DH119792

300UPVC (16.5m)

7r

11

4

5

9

286

Tarawera Rd

U16-1000/59.11

U16-1000/58.10


U16-1000/60.10

- ⊗ SWManhole
- × SWInlet
- Node
- Headwall Structure
- Culvert
- Gravity Main
- SWLead
- Catchment Boundary

STORMWATER SERVICES
1:2000 @ A3 - (U16-1000/59.10)

This data is derived from sources outside the control of Rotorua District Council and is for information only

Rotorua District Council 2006. Facsimile 07 346 3143 Telephone 07 348 4199 email mail@rdc.govt.nz

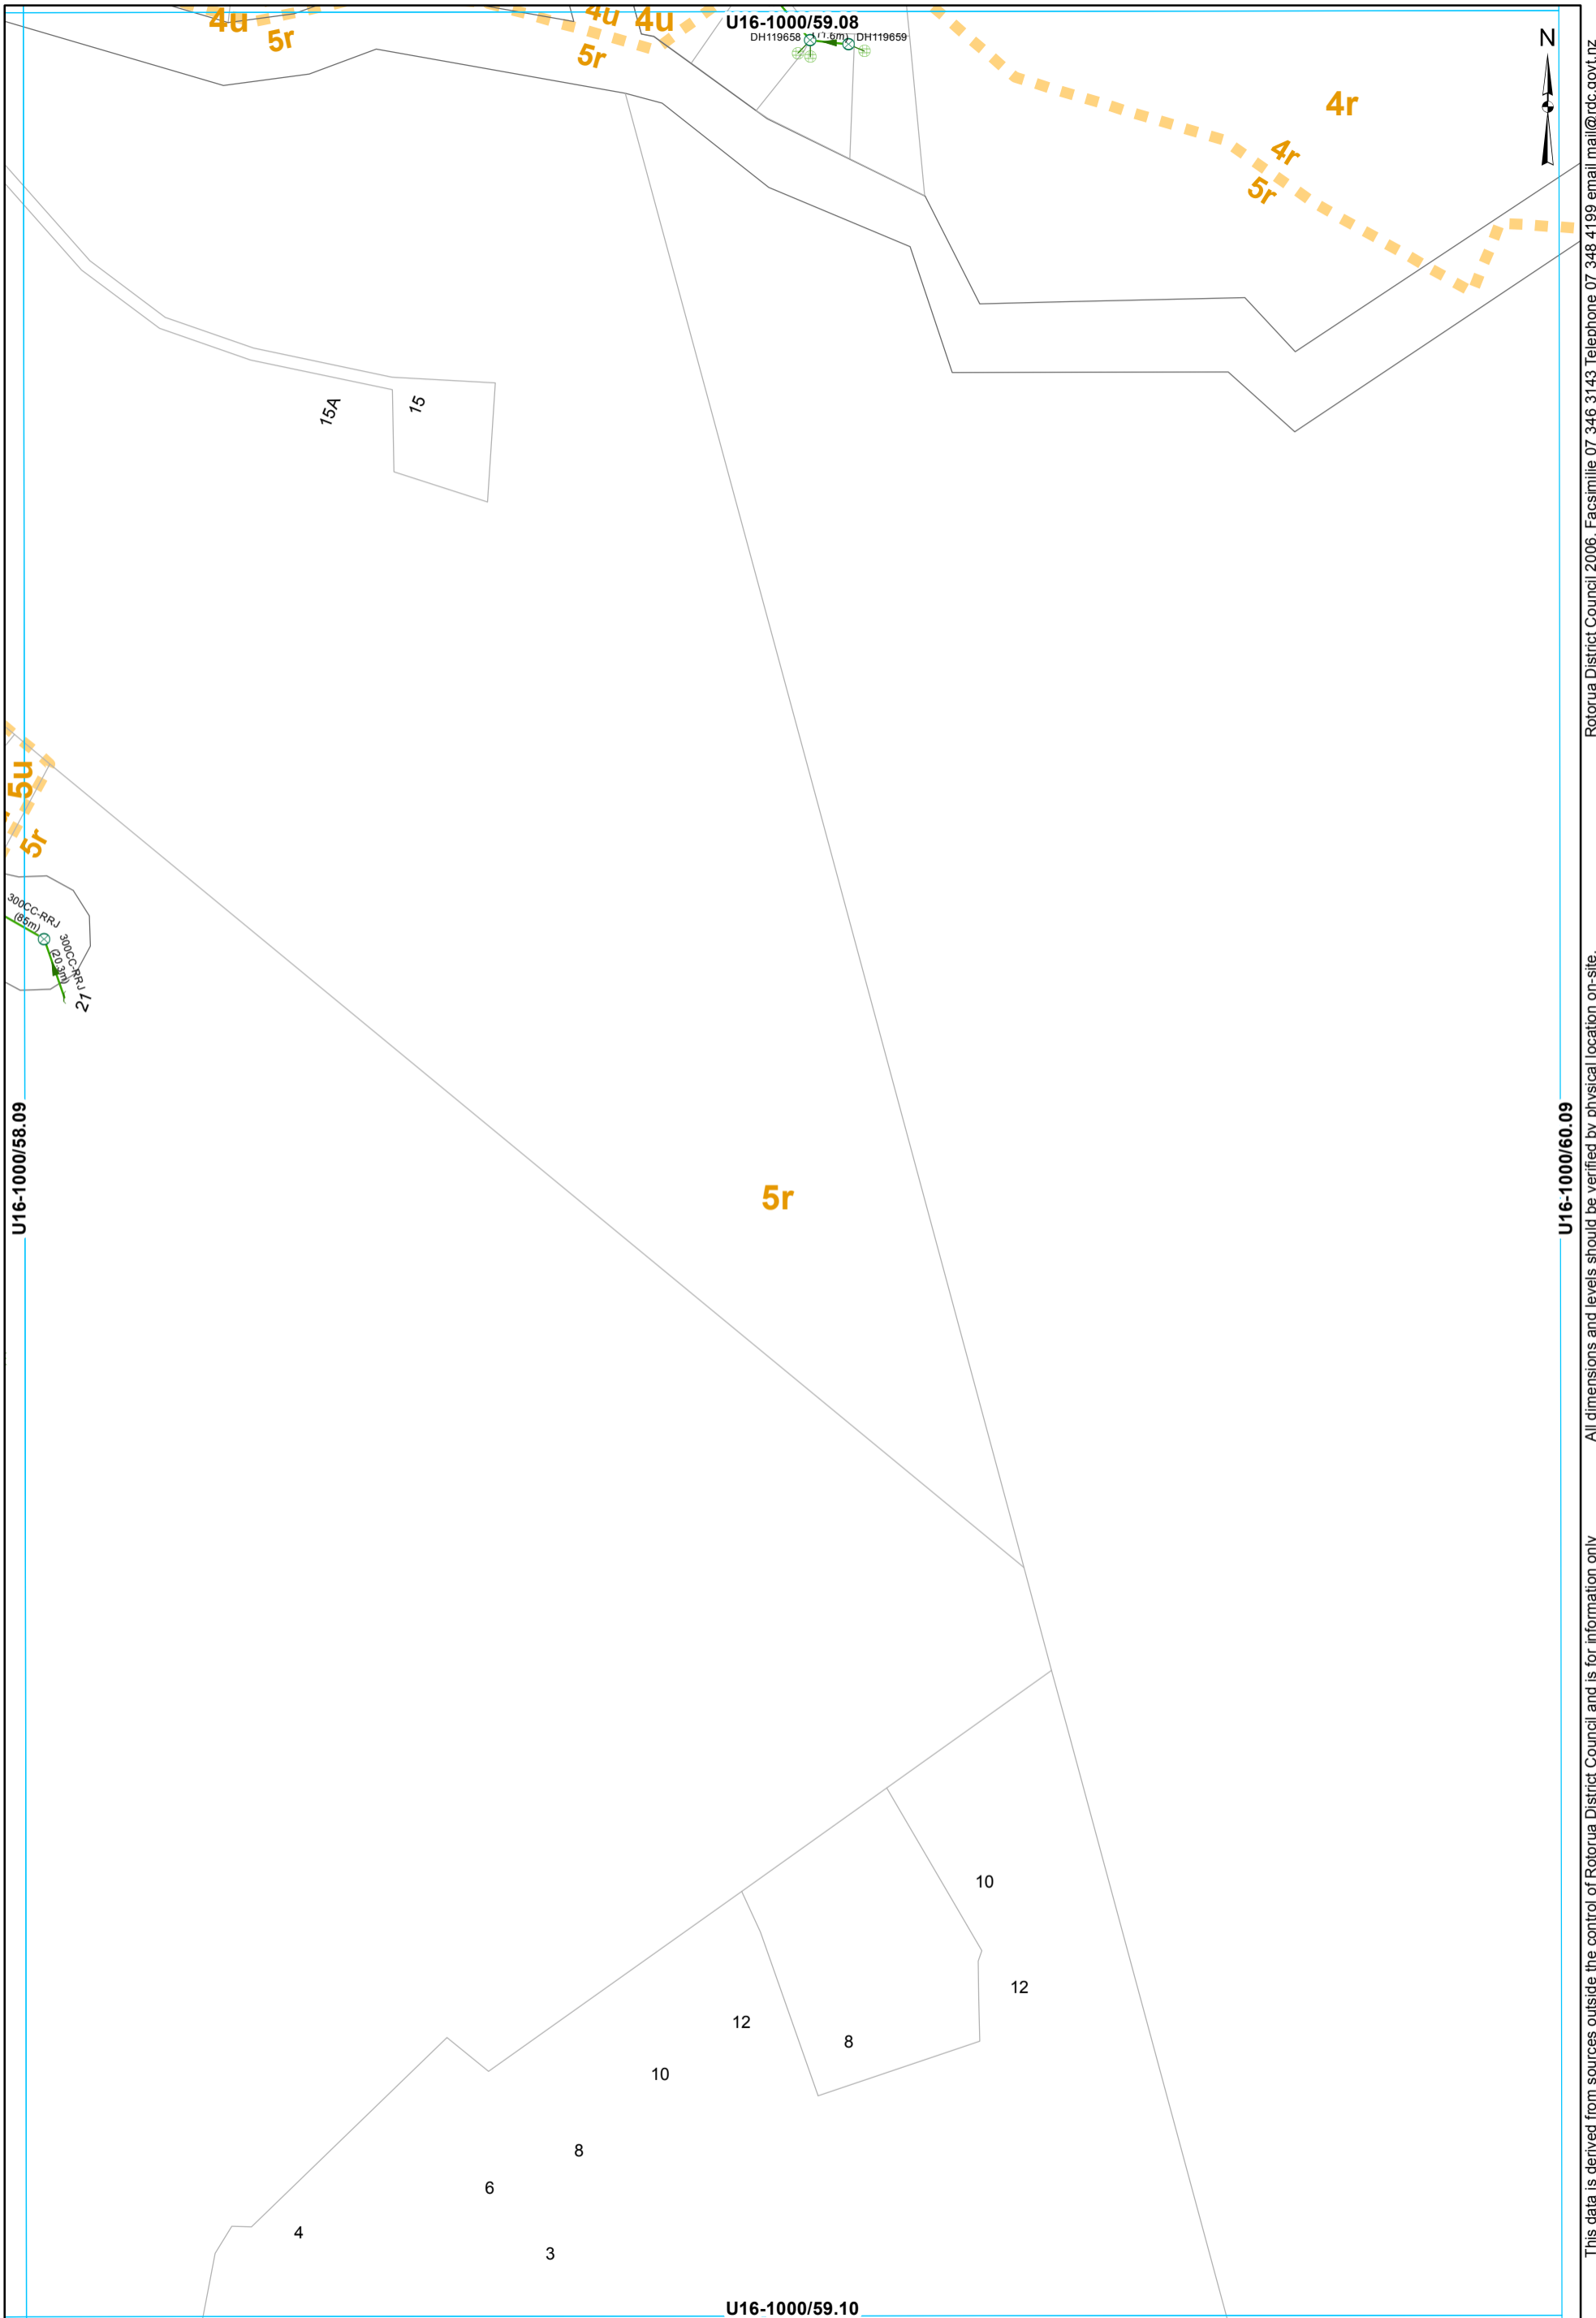

- ⊗ SWManhole
- × SWInlet
- Headwall Structure
- ⊕ Soak Hole
- Gravity Main
- SWServiceline
- SWServiceline
- ▬ Catchment Boundary

STORMWATER SERVICES
1:2000 @ A3 - (U16-1000/59.09)

This data is derived from sources outside the control of Rotorua District Council and is for information only

Rotorua District Council 2006. Facsimile 07 346 3143 Telephone 07 348 4199 email mail@rdc.govt.nz