

Storm Water Asbuil Sheet Index
SWcatchment 9u




- ⊗ SWManhole
- × SWInlet
- Node
- ┌ Capped End
- Open Drain
- Gravity Main
- SWServiceline
- SWServiceline
- SWLead
- Catchment Boundary

STORMWATER SERVICES
 1:2000 @ A3 - (U16-1000/50.07)

This data is derived from sources outside the control of Rotorua District Council and is for information only. All dimensions and levels should be verified by physical location on-site.

Rotorua District Council 2006. Facsimile 07 346 3143 Telephone 07 348 4199 email mail@rdc.govt.nz

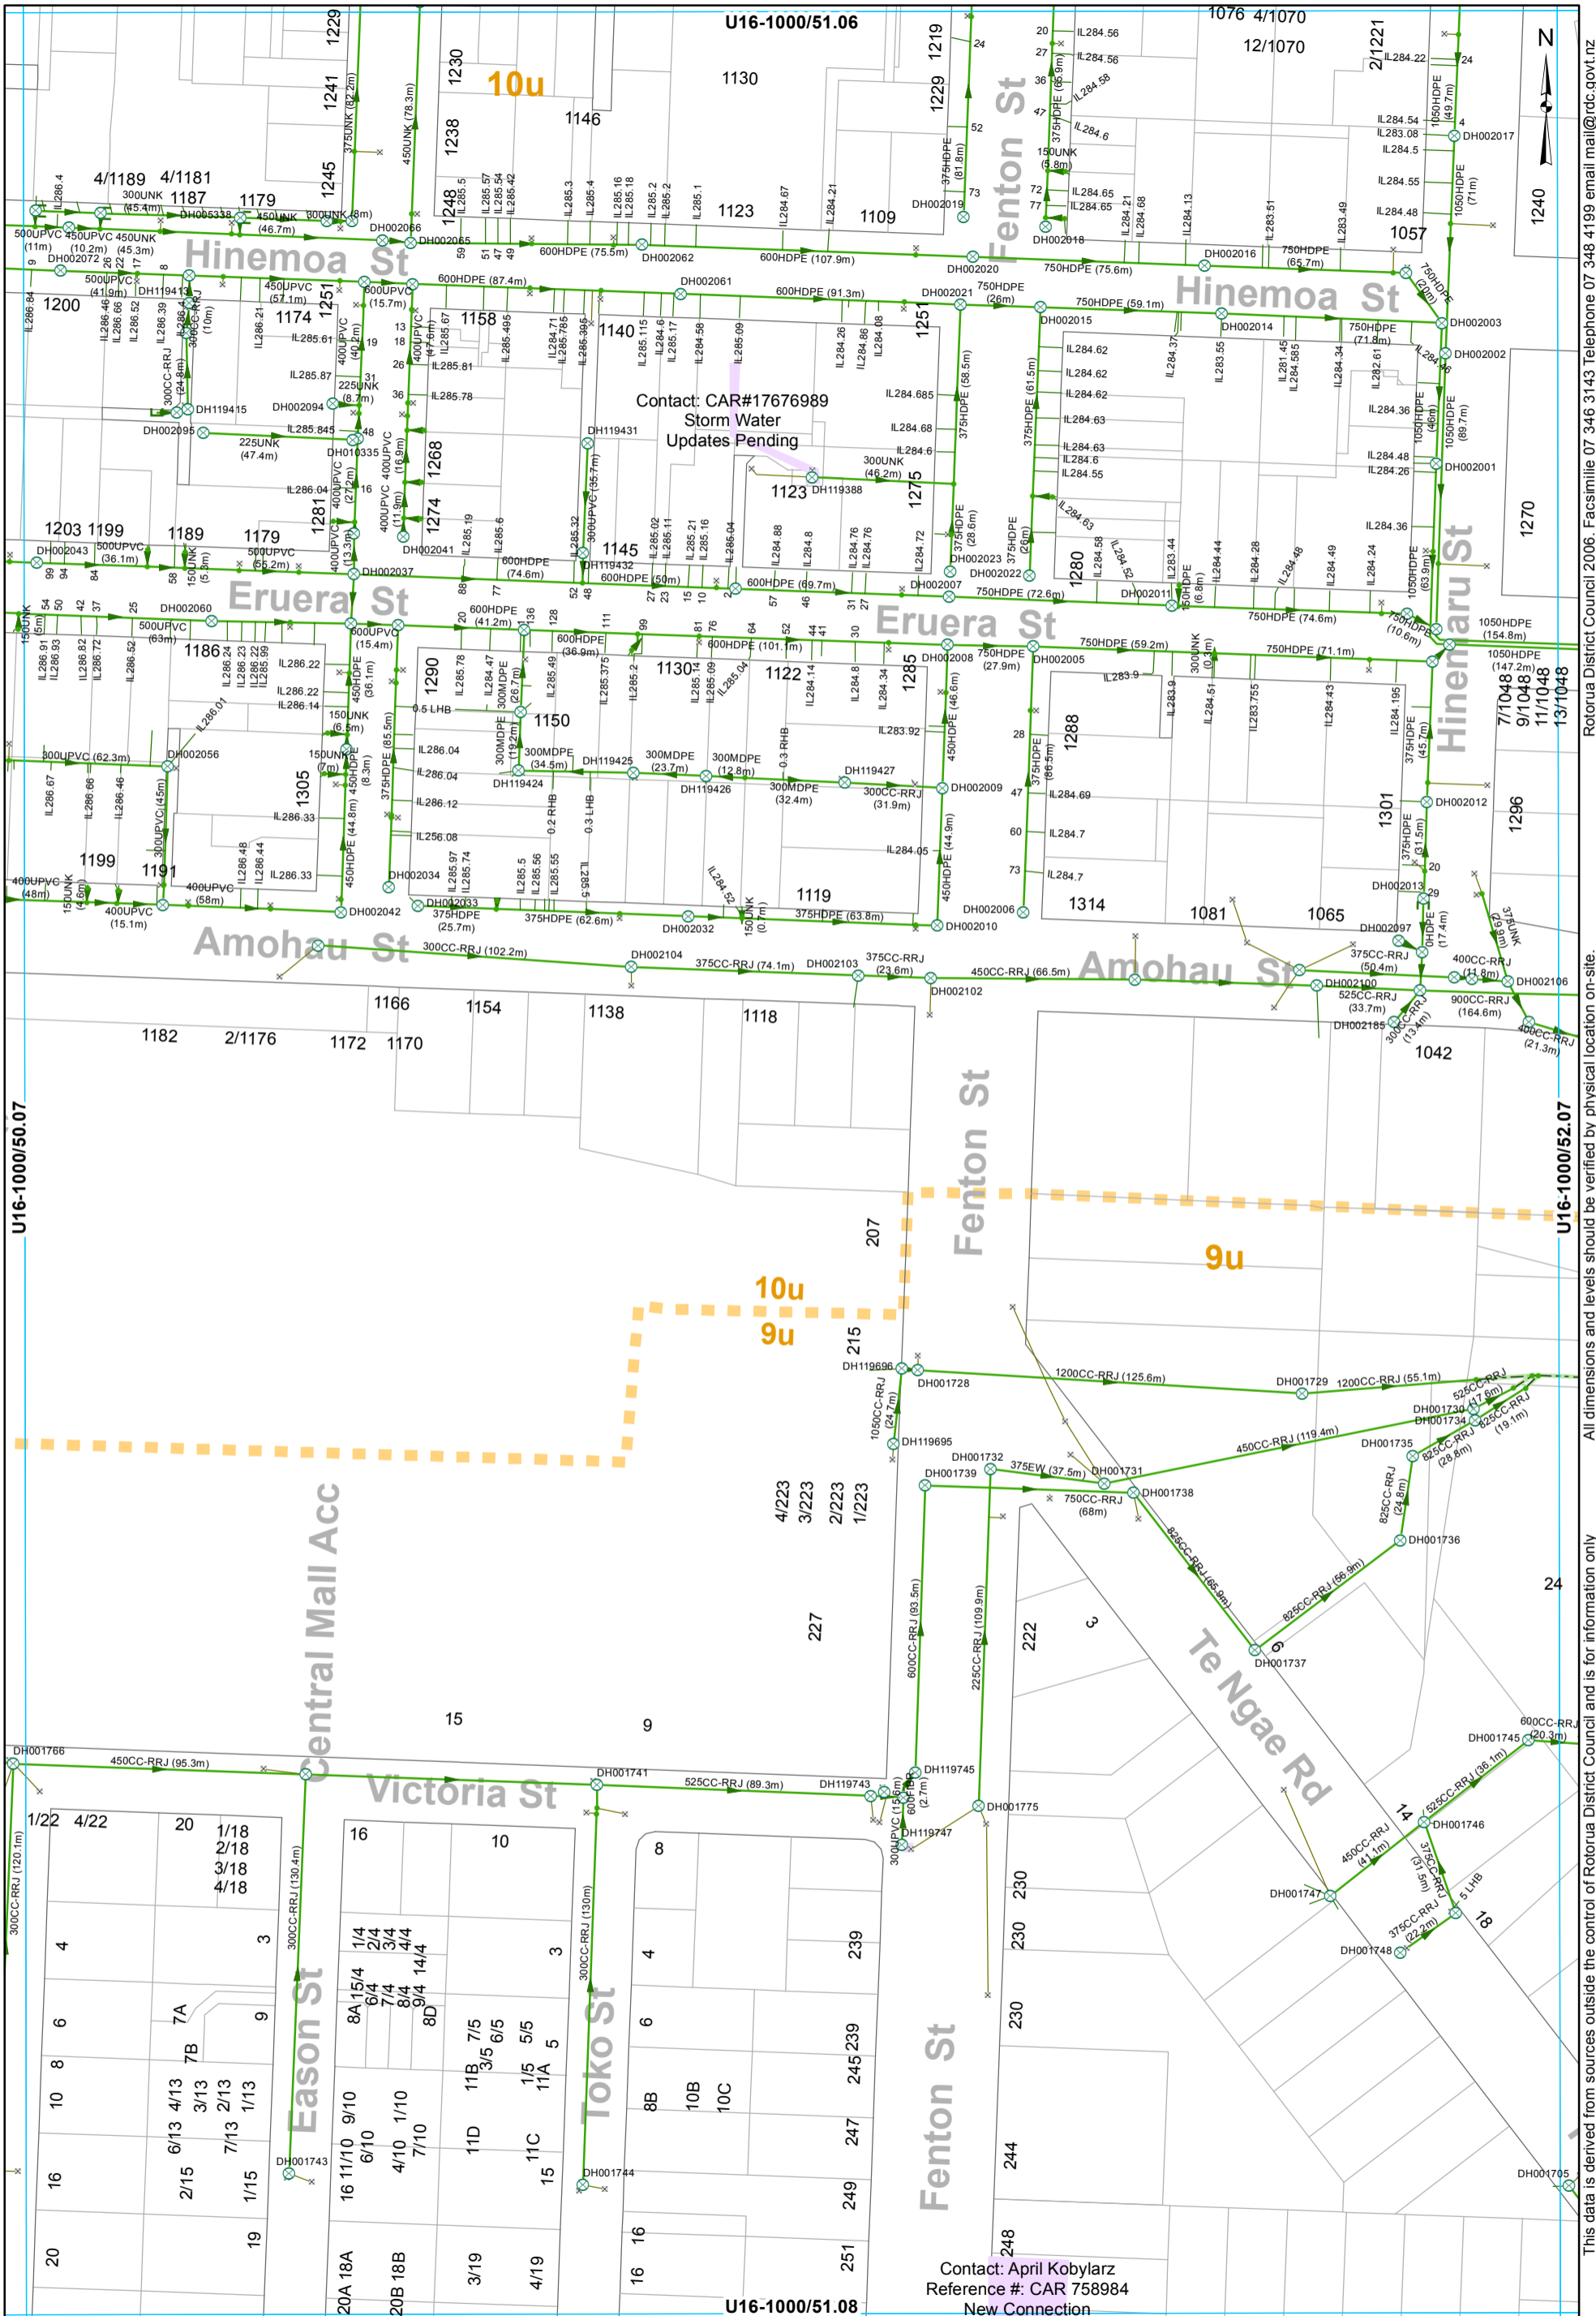

All dimensions and levels should be verified by physical location on-site.

Rotorua District Council 2006. Facsimile 07 346 3143 Telephone 07 348 4199 email mail@rdc.govt.nz

- ⊗ SWManhole
- × SWInlet
- Node
- ◻ Capped End
- Open Drain
- Gravity Main
- SWServiceline
- SWServiceline
- SWLead
- Catchment Boundary

STORMWATER SERVICES
1:2000 @ A3 - (U16-1000/51.07)



- ⊗ SWManhole
- ⊗ SWInlet
- Node
- Gravity Main
- - - Subsoil Drain
- SWServiceline
- SWServiceline
- SWLead
- - - Catchment Boundary

STORMWATER SERVICES
1:2000 @ A3 - (U16-1000/50.08)

This data is derived from sources outside the control of Rotorua District Council and is for information only

All dimensions and levels should be verified by physical location on-site.

Rotorua District Council 2006. Facsimile 07 348 3143 Telephone 07 348 4199 email mail@rdc.govt.nz



- ⊗ SWManhole
- ⊗ SWInlet
- Node
- ◻ Capped End
- Gravity Main
- SWServiceline
- SWServiceline
- SWLead
- ▭ Catchment Boundary

STORMWATER SERVICES
 1:2000 @ A3 - (U16-1000/51.08)

This data is derived from sources outside the control of Rotorua District Council and is for information only

U16-1000/52.08

Rotorua District Council 2006. Facsimile 07 346 3143 Telephone 07 348 4199 email mail@rdc.govt.nz

