

Waste Water Asbuilt Sheet Index
MOUREA

Date: 15/06/2021

U15-1000/65.31



U15-1000/64.32

U15-1000/66.32

U15-1000/65.33

This data is derived from sources outside the control of Rotorua District Council and is for information only

Rotorua District Council 2006. Facsimile 07 346 3143 Telephone 07 348 4199 email mail@rdc.govt.nz

U15-1000/64.32




U15-1000/63.33

U15-1000/65.33

U15-1000/64.34

This data is derived from sources outside the control of Rotorua District Council and is for information only. All dimensions and levels should be verified by physical location on-site.

Rotorua District Council 2006. Facsimile 07 346 3143 Telephone 07 348 4199 email mail@rdc.govt.nz

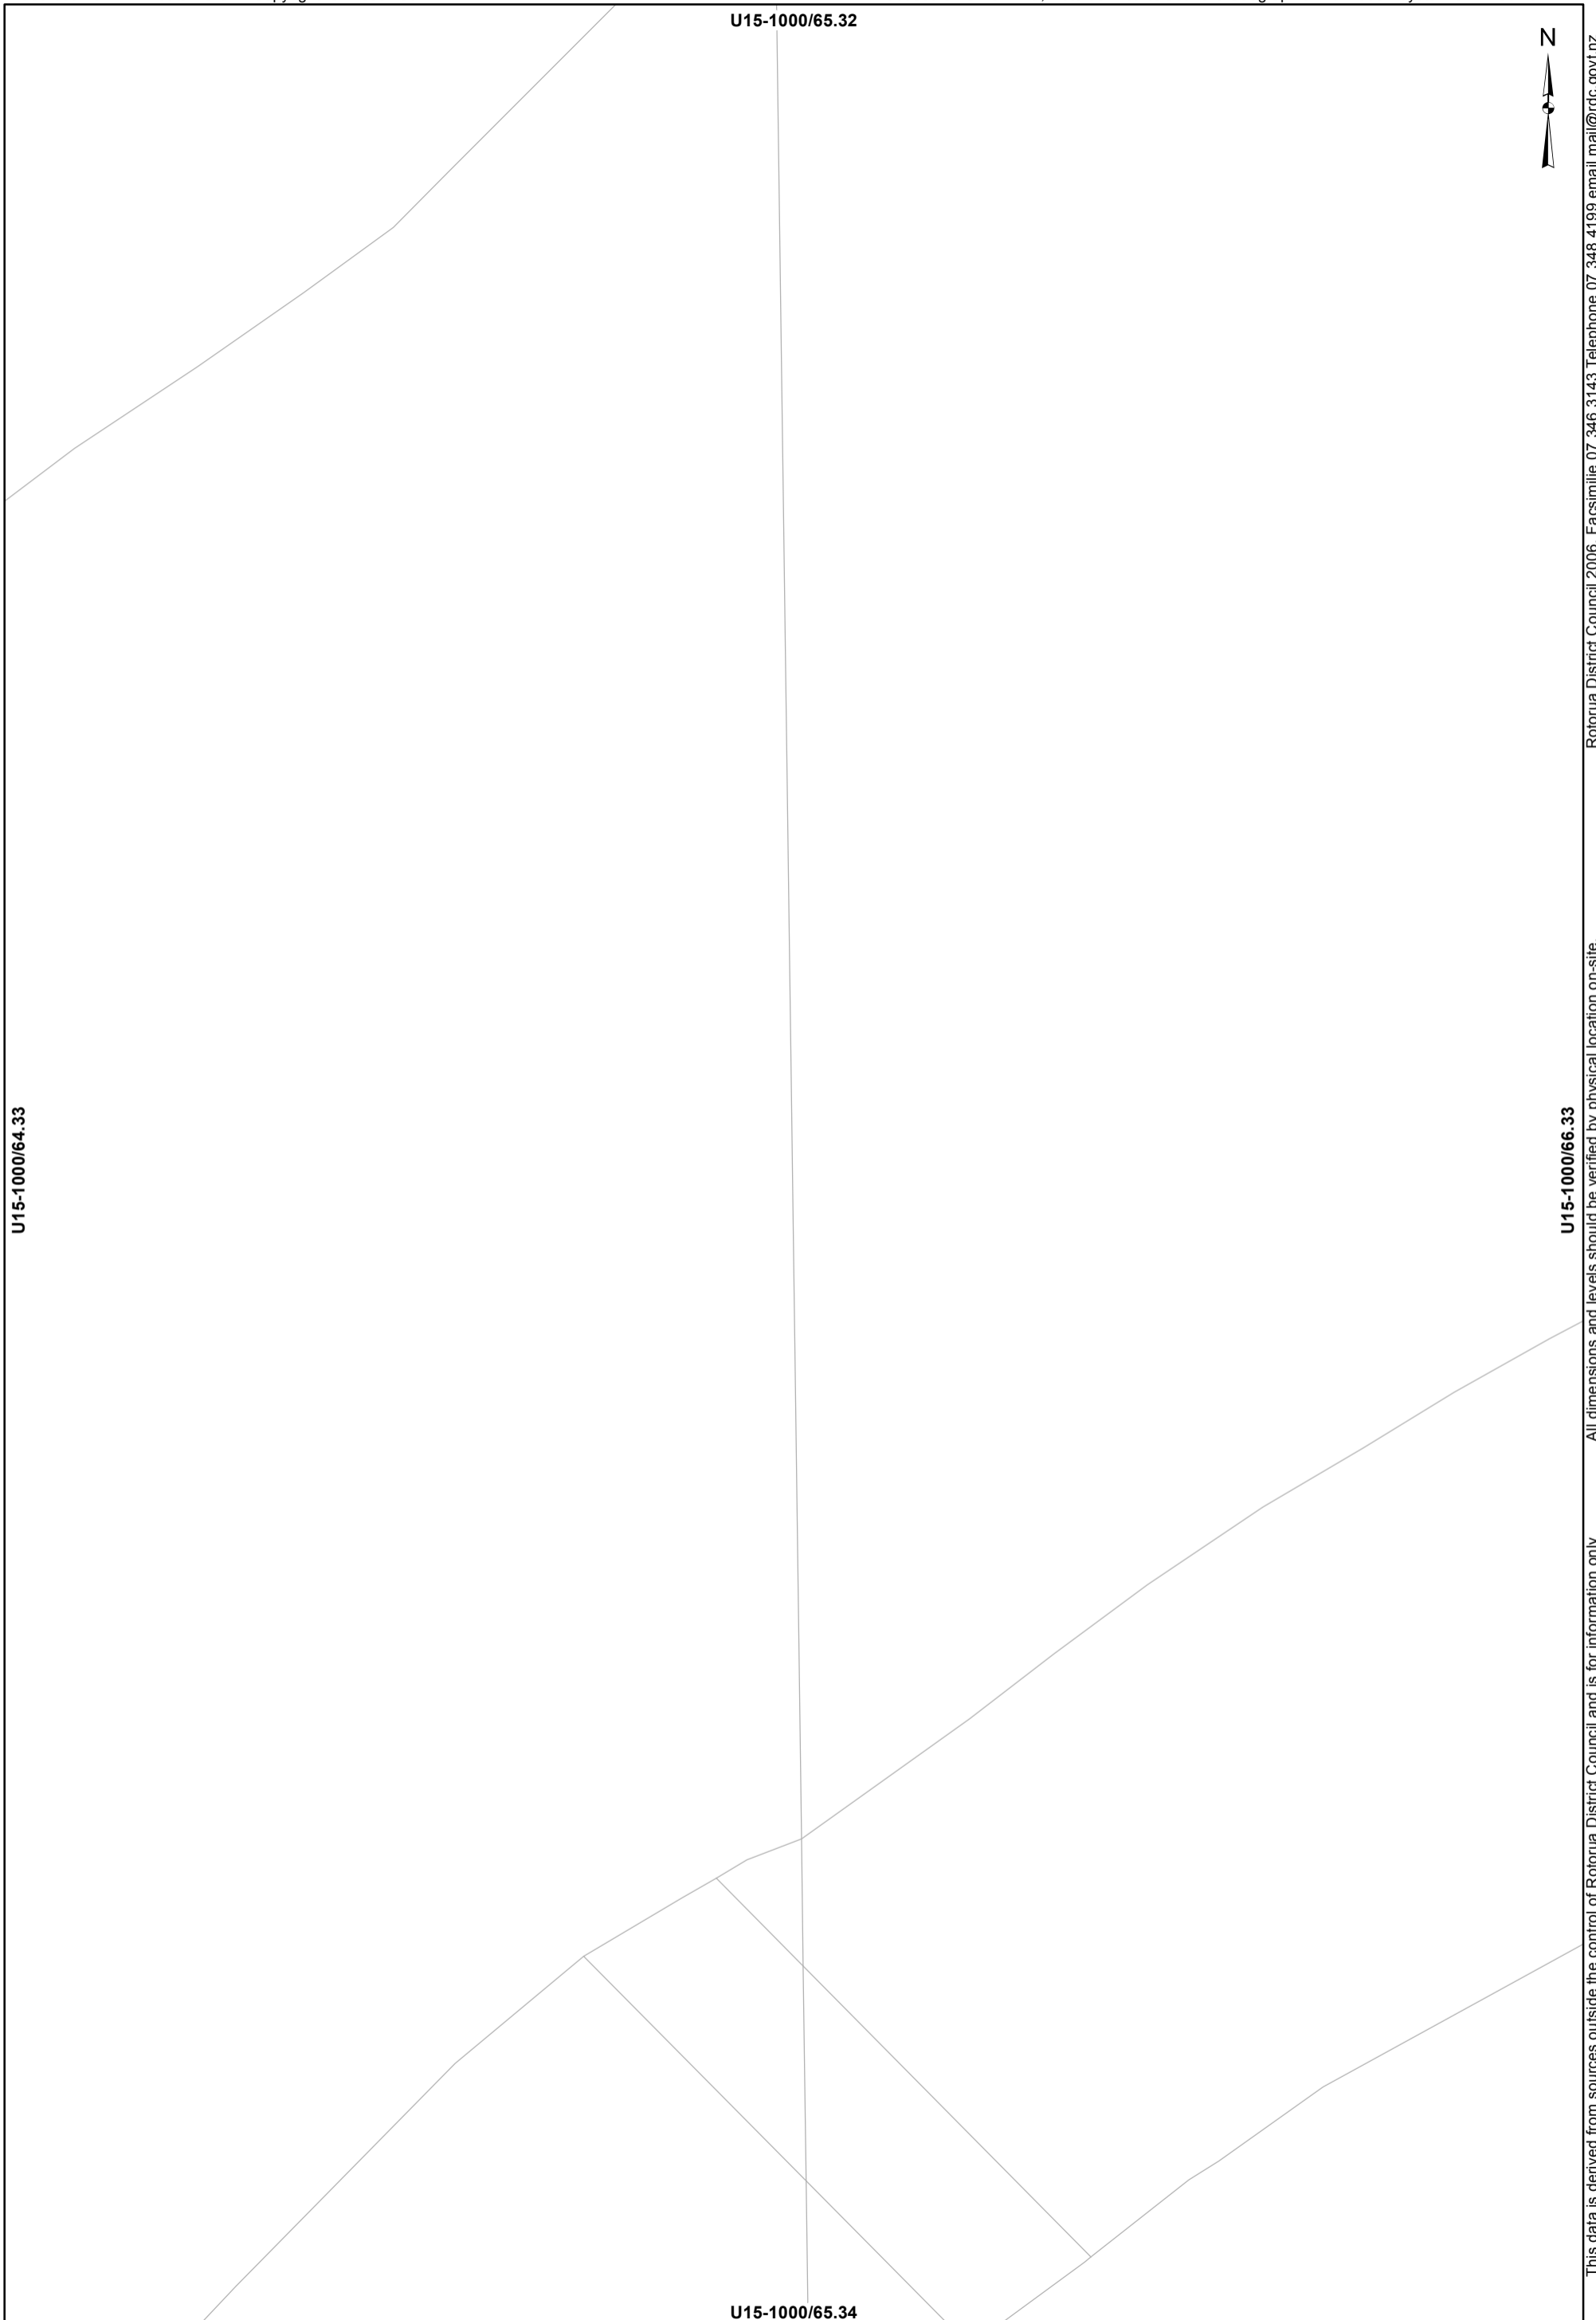

U15-1000/64.33

U15-1000/65.32



U15-1000/66.33

U15-1000/65.34

WASTEWATER SERVICES
1:2000 @ A3 - (U15-1000/65.33)

This data is derived from sources outside the control of Rotorua District Council and is for information only

Rotorua District Council 2006. Facsimile 07 346 3143 Telephone 07 348 4199 email mail@rdc.govt.nz

U15-1000/66.32



U15-1000/65.33

U15-1000/67.33

U15-1000/66.34

This data is derived from sources outside the control of Rotorua District Council and is for information only. All dimensions and levels should be verified by physical location on-site.

Rotorua District Council 2006. Facsimile 07 346 3143 Telephone 07 348 4199 email mail@rdc.govt.nz

U15-1000/64.33



U15-1000/63.34

Lake Rotorua

U15-1000/65.34

U15-1000/64.35

This data is derived from sources outside the control of Rotorua District Council and is for information only. All dimensions and levels should be verified by physical location on-site.

Rotorua District Council 2006. Facsimile 07 346 3143 Telephone 07 348 4199 email mail@rdc.govt.nz

U15-1000/65.33

N



U15-1000/64.34

U15-1000/66.34

ZEPHORE 17 (1215 1m)

U15-1000/65.35

— Rising main

WASTEWATER SERVICES
1:2000 @ A3 - (U15-1000/65.34)

This data is derived from sources outside the control of Rotorua District Council and is for information only

Rotorua District Council 2006. Facsimile 07 346 3143 Telephone 07 348 4199 email mail@rdc.govt.nz